


Section 1 Township 26 Range 38W

Well No. #1 McKinney

Company Stanolind

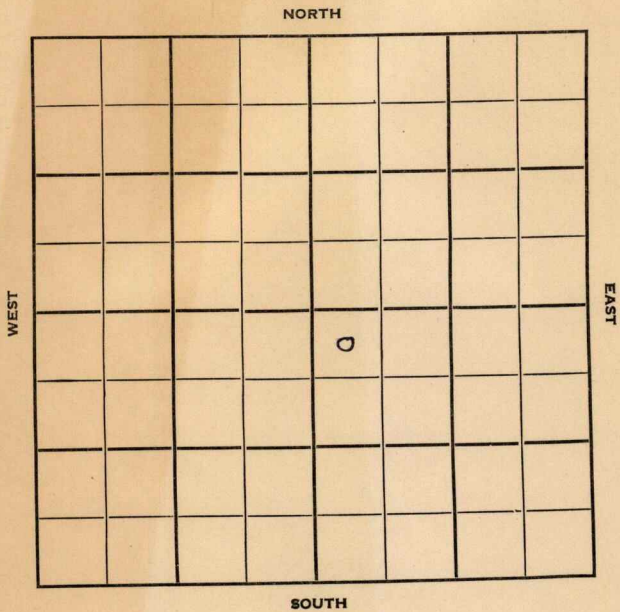

Sec. 1 Twp. 26 R. 38W ✓

Well No. #1 McKinney Farm

Stanolind Company

Contractor


3418 Ft. from N. Line

Ft. from S. Line

2630 Ft. from E. Line

Ft. from W. Line

NW NW SE

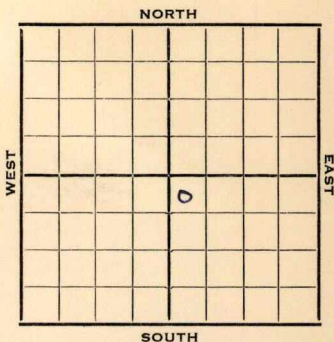

1952

Elev. 3158'

REPORT

9/24

Location

10/1

"

10/8

"

10/15

8" @ 604

Her 2420 Win 2485 Ft. Riley 2588

RTD 2615

5" @ 2589

CO @ 2585'

10/22

No report

10/29

Spud 10-3-52

Gas Well TD 2615' 8" @ 604'

Her. 2420

Win. 2485

Towanda 2534

Ft. Riley 2588

TD 2615' 5" @ 2589'

CO to 2615'

24/ 2420-24 66/ 2428-39

12/ 2442-44 18/ 2450-53

24/ 2458-64 24/ 2485-89

48/ 2498-2508 12/ 2510-12

30/ 2519-24 72/ 2537-52

72/ 2555-70 24/ 2574-80

195000 A

Comp. 11,060,000 gas

COMPLETED

County Kearny State Kansas

Sec. 1 (Blk.) 26 (Sur.) 38W Map No. (Twp.)

Operator Stanolind

Well No. 1 Farm McKinney

Elev. Location NW NW SE

3418 Ft. From N Line SE

2630 Ft. From E Line Quarter

1st. Report SEP 24 1952

Completion _____

Remarks _____

Spudding Date _____

Drlg. Data _____

Location

