


WELL LOG BUREAU—KANSAS GEOLOGICAL SOCIETY
508 East Murdock, Wichita, Kansas

Company- T.O. LILYSTRAND, JR., -A LIMITED PARTNER- SEC. 15 T. 26 R. 10W
Farm- Merle Fluke No. 1 SHIP NE NW NW

Total Depth. 4400'
Comm. 1-24-57 Comp. 2-10-57
Shot or Treated.
Contractor. Stickle Drlg. Co.
Issued. 3-9-57

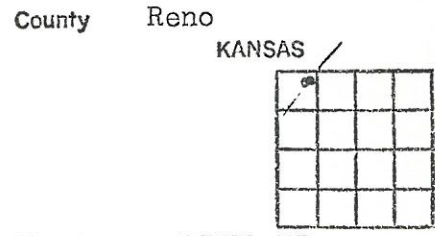

CASING:
8" 305'

Elevation. 1727' RB

Production. Dry

Figures indicate Bottom of Formations.

sand	60
red bed-shells	306
red bed-shale	425
shale-shells	1000
Anhydrite	1040
shale-shells	1560
shells-shale-sand	1700
lime	1835
lime-shale	2170
shale-lime shells	2345
shale-shells	2585
shale-lime	2725
lime-shale brks	2950
shale-shells	3115
lime-shale	3405
shale-shells	3455
lime	3550
Kansas City lime	3610
lime	3845
lime-shale	3903
lime	3955
Conglomerate chert	3966
lime chert	4002
lime	4022
shale	4088
shale-lime	4140
shale	4205
Dolomite	4230
lime	4279
Viola lime	4300
sand	4310
lime	4400
Total Depth	

TOPS: Scout	
Heebner	3271
Brown lime	3454
Lansing	3471
B/Kansas City	3832
Conglomerate	3944
Mississippi	3953
Kinderhook	4018
Maquoketa	4131
Viola	4197
Simpson	4286
Arbuckel	4369