


Section 5 Township 26 Range 10W

Well No. 1 Hickman

Company Rupp-Ferguson

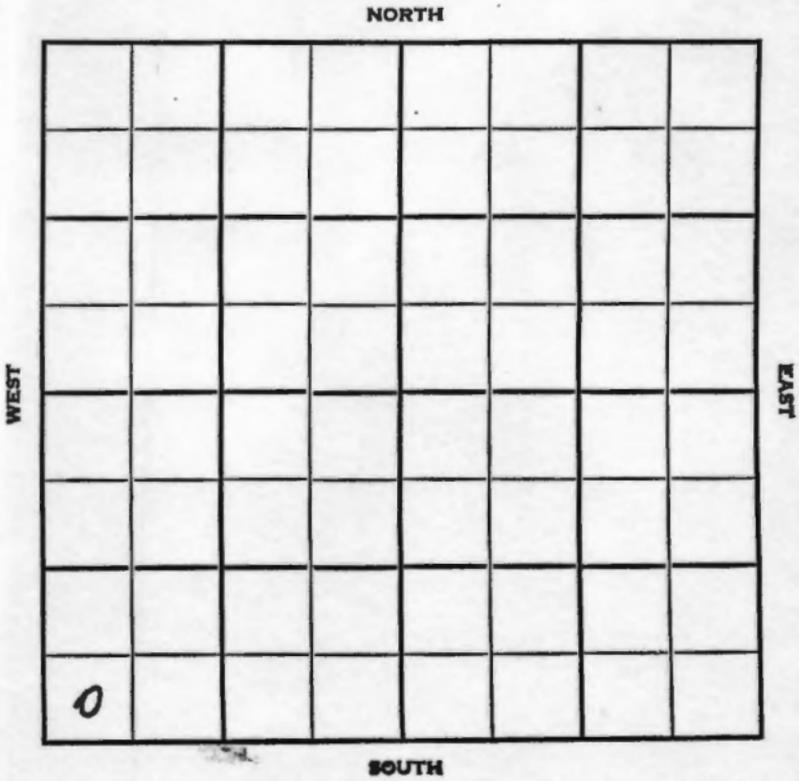

Reno KANSAS


SEC. 5	TWP. 26	R. 10W
-----------	------------	-----------

WELL NO. **1 Hickman** FARM

COMPANY **Rupp-Ferguson**

CONTRACTOR **Co. Tools Wildcat**

\_\_\_\_\_ Ft. from N. Line  
**330** \_\_\_\_\_ Ft. from S. Line  
 \_\_\_\_\_ Ft. from E. Line  
**330** \_\_\_\_\_ Ft. from W. Line

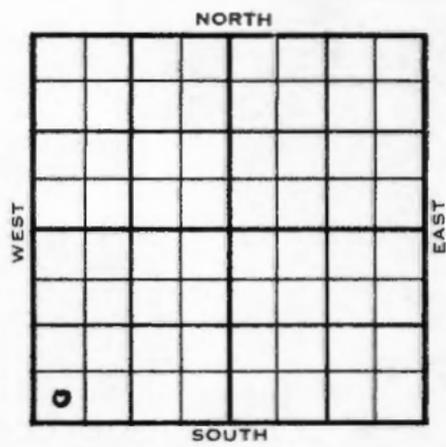

SW SW SW

1954	ELEVATION 1762'	REPORT
------	--------------------	--------

8/25  
9/29

Location  
 Spud 9-11-54 - D&A  
 TD 4379'  
 8-5/8" @ 265'  
 Heeb 3322', Br. lime 3498', Lans 3510',  
 Miss 3973', Kh. 4042', Viola 4202',  
 Simp. 4301'  
 TD 4379'  
 D&A

**ABANDONED**



