


KANSAS

Reno County

Section 16 Township 26 Range 10W

Well No. #1 Baden

Company Phillips et al

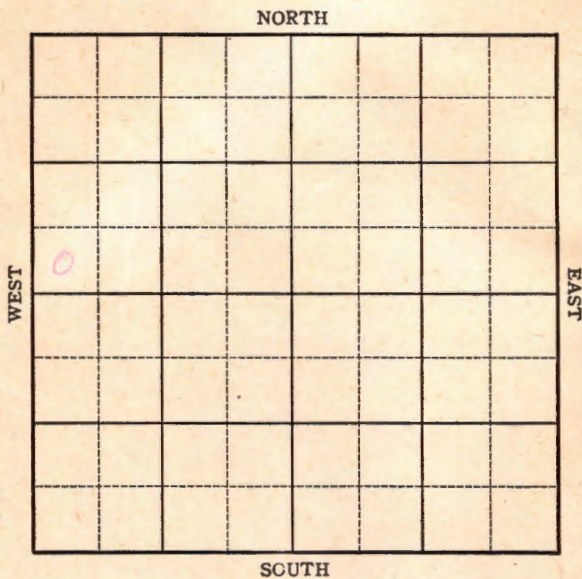

KANSAS

Reno County

Special

Sec. 16 Twp. 26 R. 10W

Well No. #1 Baden Farm

Phillips et al Company


Wildcat

Ft. from N. Line

330 Ft. from S. Line

Ft. from E. Line

330 Ft. from W. Line

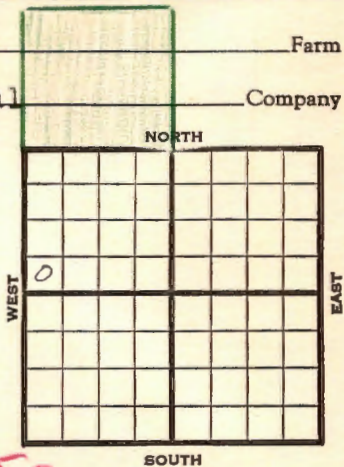

SW NW Elev. 1750

REPORT

1945

3/28 RUR

4-4 Set 8" @ 443' Waiting on cement.

4-12 Drilling 2805'

4-18 Drilling 3735'

5/2 Topeka 2946

Lans 3507

Miss 3979

Viola 4223

Arb 4396

TD 4428'

ABANDONED

Pool Name WildcatMap No. 47 Sec. 16 Twp. 26- R. 10WWell No. 1 BadenPhillips et al


Company

FIRST REPORT

Contractor

SW "W

SECTION PLAT

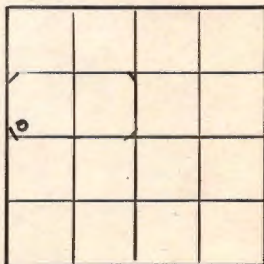

Ft. from N. Line

330 Ft. from S. Line

Ft. from E. Line

330 Ft. from W. Line

Reno

Location

Rig up

Drilling and Remarks:

RUR

Hot Hole

RECORD

Cased _____ in. _____ ft.

Sand _____

Gas _____

Oil _____

Total Depth _____

PRODUCTION

1st 24 hrs. Nat. _____

1st 24 hrs. after shot _____

Gas _____ Cu. Ft.

Dry Hole _____

Abandoned _____

Date

MAR 28 1945

19

S. J. LEWIS

Scout

Kansas Pool Name WildcatMap No. 47 Sec. 16 Twp. 26 R. 10WWell No. 1 PadenPhillips etal Company**ABANDONED**

Contractor

SW NW

E11250**SECTION PLAT**

0			

Ft. from N. Line330 Ft. from S. LineFt. from E. Line330 Ft. from W. LineReno County

Location _____

Rig up _____

Drilling and Remarks:


Cased _____ in., _____ ft.

Sand _____

Gas _____

Oil _____

Total Depth 4428**PRODUCTION**

1st 24 hrs. Nat. _____

1st 24 hrs. after shot _____

Gas _____ Cu. Ft.

Dry Hole _____

Abandoned _____

Date

MAY 2 1945 19S. J. LEWIS Scout