


Section 21 Township 26 Range 10W

Well No. #1 Haynes

Company Bennett & Roberts

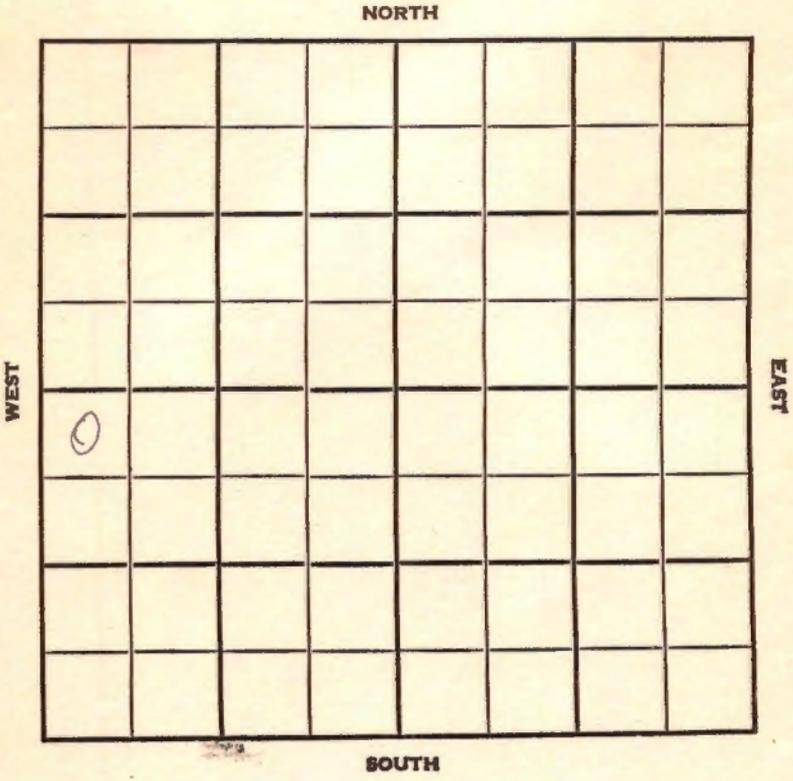

County Teno Elev. 1757
 Sec. 21 Twp. 26 Rge. 10W
 Company Bennett & Roberts
Haynes No. 1

TOPS	DEPTH	LOG	DATUM	Loc. in Sec.
Anh.				NW NW SW
Tr.	2955			
H.	3349			
Tr.	3370			
Dg.	3379			
Bl.	3525			
L.	3542			
K.C.				Geol.
B.K.C.				Contr.
Ce.	<i>D&A</i>			Co. Tools
C.				Pool
M.	4002			Wildcat
M.				ABANDONED
K.				
Mz.				
Mo.				
V.	4273			
S.	<i>sd</i> 4444-47			
S.				
A.	4454			
R.				
PE.				
G.				
TD.	4490			DEC 5 '56

Date Comm. spd. 11-14-56 Sunray, DHM Ohio
 8" @ 258 w/200, drlg. 3150, NOV 28 '56 X

TP 2955 H6 3349 BL 3525 Ls9 3542
 MISS 4002 V10 4273 ~~Pipe~~ ~~stock~~ @
~~4285~~ DST 4264-85 up 90" rec
 270' 9554 MW + 1180' SW BHP 435'
 @ ahead. DST 3990-4020 1 1/2"
 1320' 6 1/2" rec 150' GCM (550)
 BHP 1090/30 DEC 5 '56

D&A

WILDCAT

FORM 513 SUNRAY

County Reno Elev. _____
Sec. 21 Twp. 26 Rge. 10W
Company Bennett & Roberts
Farm Name Haynes No. 1

TOPS	DEPTH	LOG	DATUM	Loc. in Sec. _____																														
Anh.				NW NW SW																														
Tr.																																		
Dg.																																		
Bl.																																		
L.				Geol. _____																														
K.C.				Contr. _____																														
B.K.C.				Co. Tools _____																														
Ce.				Pool _____																														
C.				<u>Wildcat</u>																														
M.				<table border="1"><tr><td></td><td></td><td></td></tr><tr><td></td><td></td><td></td></tr><tr><td></td><td></td><td></td></tr><tr><td></td><td></td><td></td></tr><tr><td></td><td></td><td></td></tr><tr><td></td><td></td><td></td></tr><tr><td></td><td></td><td></td></tr><tr><td></td><td></td><td></td></tr><tr><td></td><td></td><td></td></tr><tr><td></td><td></td><td></td></tr></table>																														
Mz.																																		
Me.																																		
V.																																		
S.																																		
S.																																		
A.																																		
R.																																		
PE.																																		
G.																																		
T.D.																																		

Date Comm. spd. 11-14-56 Sunray, DHM Ohio DHM
8" @ 258 w/200, drlg. 3150,

279

NOV 15 1956
M.M