


Section 10 Township 26 Range 38-W

Well No. #1 Anderson "B"

Company Stanolind

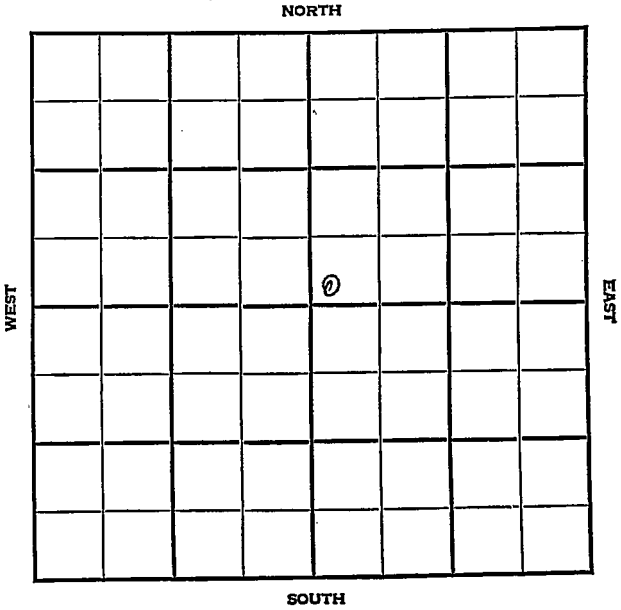

KANSAS

Kearny



Sec. 10 Twp. 26 R. 38W

Well No. #1 Anderson "B" Farm

Stanolind

Company


Hugoton Pool

_____ Ft. from N. Line

150' Ft. from S. Line

_____ Ft. from E. Line

150' Ft. from W. Line

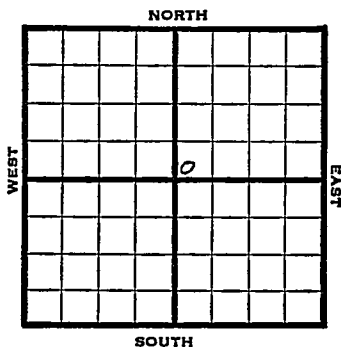

SW NE

1948

Eli 3198'

REPORT

7/14

Location

7/21

"

7/28

"

8/4

"

8/11

"

8/18

Loc

Aband.

ABANDONED

Map No. _____ Sec. 10 Twp. 26 R. 38W

Well No. 1 Anderson "B"

Stanolind Company

FIRST REPORT

Contractor

SW NE

SECTION PLAT

_____ Ft. from N. Line

150 Ft. from S. Line

_____ Ft. from E. Line

150 Ft. from W. Line

		o	

Kearny County

Location X

Rig up _____

Drilling and Remarks: _____

RECORD

Cased _____ in., _____ ft.

Sand _____

Gas _____

Oil _____

Total Depth _____

PRODUCTION

1st 24 hrs. Nat. _____

1st 24 hrs. after shot _____

Gas _____ Cu. Ft.

Dry Hole _____

Abandoned _____

Date

JUL 14 1948 19

S. J. LEWIS

Scout

Kearny County Kansas State
Map No. _____ Sec. 10 Twp. 26 R. 38W

Well No. I Anderson "B"

Stanolind Company

ABANDONED

Contractor

SW NE

E. I. 3198

SECTION PLAT

_____ Ft. from N. Line

150 Ft. from S. Line

_____ Ft. from E. Line

150 Ft. from W. Line

Hugoton Pool

Remarks:

Loc



Date
AUG 18 1948

Scout **S. J. LEWIS**