


Section 10 Township 26 Range 39W

Well No. #1 J. Lampe

Company United Production

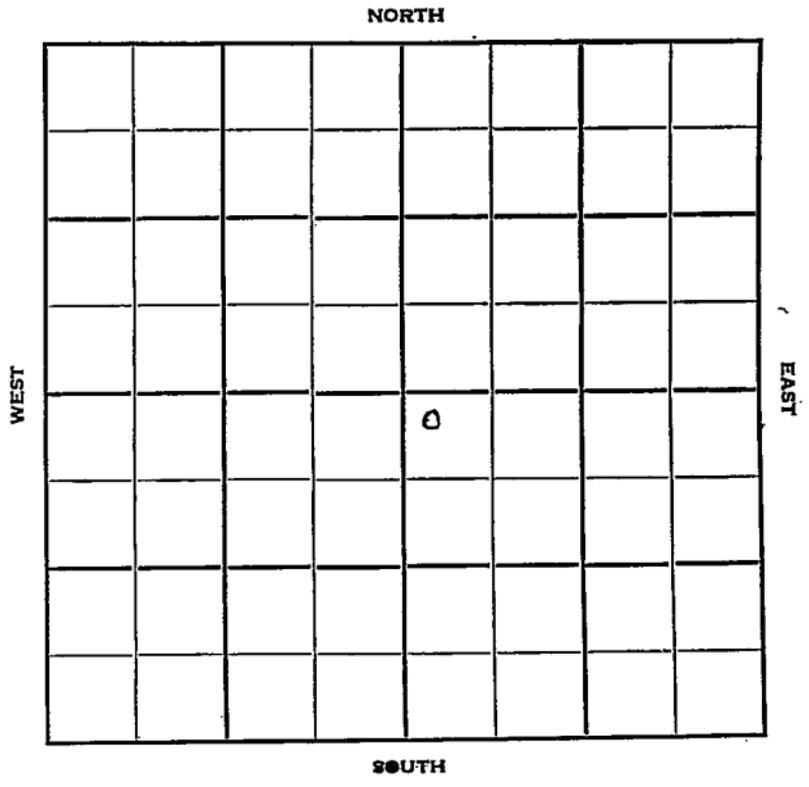

Sec. 10 Twp. 26 R. 39W

Well No. #1 J. Lampe Farm

United Production Company

Contractor


150 Ft. from N. Line

_____ Ft. from S. Line

_____ Ft. from E. Line

150 Ft. from W. Line

NW SE

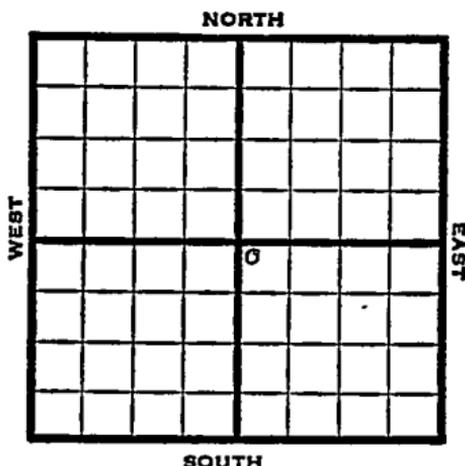

1951

Elev. 3357' REPORT

10/31

Location

1952

1/2 Spud 11-9-51
 Gas well TD 2597' 10" @ 439'
 7" @ 2437' TD 2597' Her 2493'
 Kri 2520' Win 2580' 23,000 A
 Comp. 17,000,000 gas

COMPLETED

County Hamilton State Kansas

Sec. 10 (Blk. 26 (Sur. 39W (Twp.) (Rge.) Map No.

Operator United Production

Well No. 1 Farm J. Lampe

Elev. 3357 Location NW SE

COMPLETE

150 Ft. From N Line SE

150 Ft. From W Line Quarter

Ist. Report

Completion JAN 2 1952

Remarks

Spudding Date 11-9-51

Drlg. Data Gas well TD 2597

10" @ 439 7" @ 2437 TD 2597

Her. 2493 Kri. 2520 Win. 2580

23000 A Comp. 17,000,000 gas

J. E. TYRA