

KANSAS

Kearny


FORM 51 IOM 12-46 PETROL

Section 10 Township 26 Range 35- W

Well No. 9 Building & Loan

Company Helmerich & Payne

Hugoton Pool NORTH

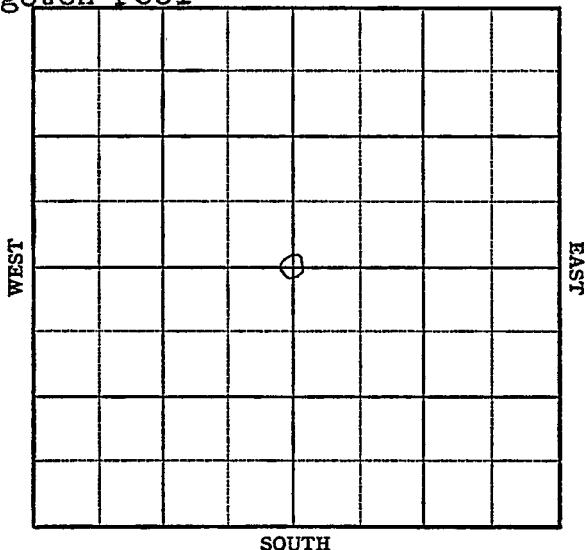

KANSAS

Kearny

Sec. 10 Twp. 26 R. 35W

Well No. #9 Building & Loan Farm

Helmerich & Payne Company
Hugoton


2640 Ft. from N. Line

 Ft. from S. Line

2640 Ft. from E. Line

 Ft. from W. Line

C Sec.

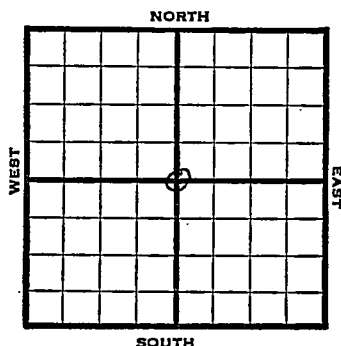

REPORT

1947	
9/17	Location
9/24	"
10/1	"
10/8	10" @ 803'
10/15	TD 2941' 7" @ 2538' RUST
10/22	"
10/29	Drlg. 2650'
11/5	"
11/12	TD 2750' 15000 acid.
11/19	"
11/25	"
12/3	"
12/10	7" @ 2538' 230' of 5" Perf. liner - 15000 acid. 1,048,000 gas. 419# R. Pr. TD 2750'

COMPLETED

Map No. 0 Sec. 10 Twp. 26 R. 35W

Well No. 9 Building & Loan

Helmerich & Payne Company

FIRST REPORT Contractor

C Sec.


SECTION PLAT

2640 Ft. from N. Line

 Ft. from S. Line

2640 Ft. from E. Line

 Ft. from W. Line

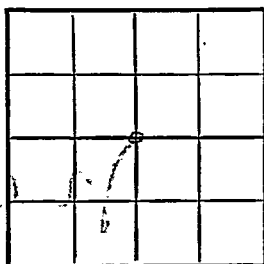

Kearny County

Location X

Rig up

Drilling and Remarks:

RECORD

Cased in., ft.

Sand

Gas

Oil

Total Depth

PRODUCTION

1st 24 hrs. Nat.

1st 24 hrs. after shot

Gas Cu. Ft.

Dry Hole

Abandoned

Date

SEP 17 1947 19 S. J. LEWIS Scout

Map No. _____ Sec. 10 Twp. 26 R. 35W

Well No. 9 Building & Loan

Helmerich & Payne Company

COMPLETE Contractor

C Sec.


2640 Ft. from N. Line

_____ Ft. from S. Line

2640 Ft. from E. Line

_____ Ft. from W. Line

SECTION PLAT

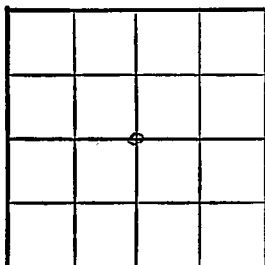

Kearny County

Location _____

Rig up _____

Drilling and Remarks:

*7" C2538
20' x 5" Pay liner
10000 acc*

1,048,000 Gal

419 # R/P

RECORD

Cased _____ in., _____ ft.

Sand _____

Gas _____

Oil _____

Total Depth 2250

PRODUCTION

1st 24 hrs. Nat. _____

1st 24 hrs. after shot _____

Gas _____ Cu. Ft.

Dry Hole _____

Abandoned _____

Date

DEC 10 1947 19 _____ S. J. LEWIS Scout