


Section 10 Township 26 Range 33W

Well No. #1 Drussell

Company Cities Service

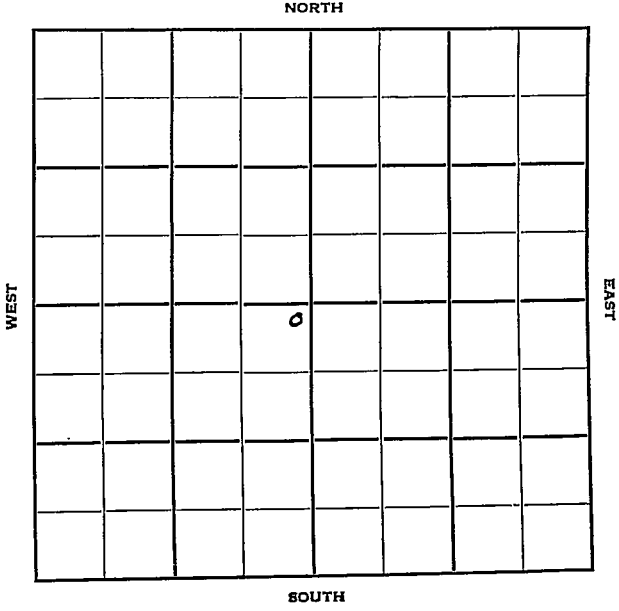

Finney
26

KANSAS

33W ✓

Sec. 10 Twp. R.

#1 Drussell

Well No. Farm

Cities Service

Company

Hugoton Pool


Contractor

100' Ft. from N. Line

Ft. from S. Line

100' Ft. from E. Line

Ft. from W. Line

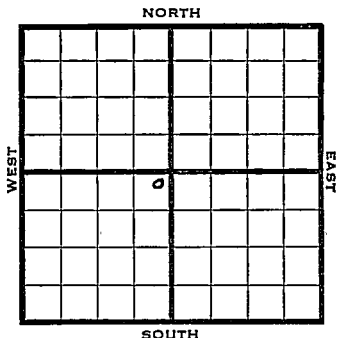

NE SW

1950

Elev 2895

REPORT

4/26

Location

6/7

8" @ 800

5" @ 2729

Hev 2540

U Kv 2570

Win 2622

open flow 13,600,000 cu ft

Completed TD 2730

COMPLETED

Kansas

Hugoton Pool

Map No. _____ Sec. 10 Twp. 26 R. 33W

Well No. 1 Drussell

Cities Service Company

Contractor

NE SW

SECTION PLAT

100 Ft. from N. Line

_____ Ft. from S. Line

100 Ft. from E. Line

_____ Ft. from W. Line



Finney County

Location X

Rig up _____

Drilling and Remarks:

RECORD

Cased _____ in., _____ ft.

Sand _____

Gas _____

Oil _____

Total Depth _____

PRODUCTION

1st 24 hrs. Nat. _____

1st 24 hrs. after shot _____

Gas _____ Cu. Ft.

Dry Hole _____

Abandoned _____

Date

APR 26 1950 19

J. E. TYRA Scout

Scout Cards
Land Small Map
Land Wall Map
Tracings
France Map
Pierce Map
Misc.

WASH 1 2 1924

Kansas

Map No. _____ Sec. 10 Twp. 26 R. 33W

Well No. 1 Drussell

Cities Service Oil Company

NE SW El. 2895 Contractor

SECTION PLAT

100 Ft. from N. Line

_____ Ft. from S. Line

100 Ft. from E. Line

_____ Ft. from W. Line

COMPLETE			
	o		

Finney

RECORD

Location _____

Cased _____ in., _____ ft.

Rig up _____

Sand _____

Drilling and Remarks:

Gas _____

Oil _____

Total Depth 2730

8" @ 800

5" @ 2729

Kev 2540

UKV 2570

Win 2622

T.D. 2730

penflow

PRODUCTION

1st 24 hrs. Nat. _____

1st 24 hrs. after shot _____

Gas _____ Cu. Ft.

Dry Hole _____

Abandoned _____

Date 13,600,000 Cu ft.

Maple

W.H.W.

We must

Have Total
Depth

Please do not

Send any tickets

well out T.D.

Sam

Scout Cards	76
Land Small Map	
Land Wall Map	3
Tracings	
France Map	
Pierce Map	
Misc.	

JUN 15 1930

Date