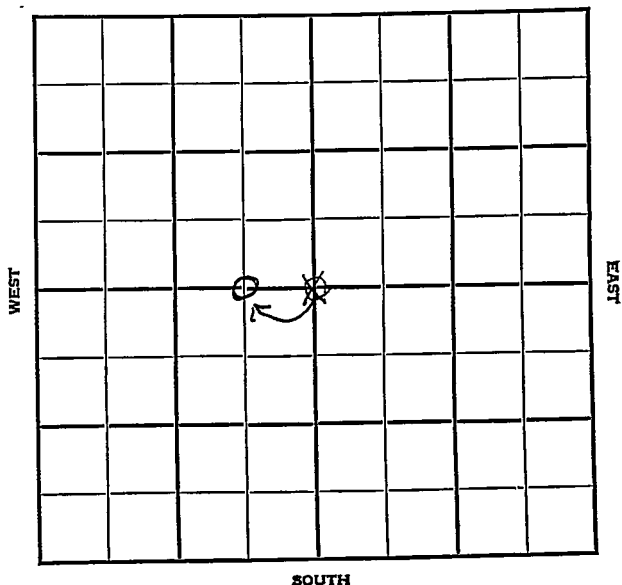


Section 10 Township 26 Range 34^WWell No. #2 GovernmentCompany Helmerich & PayneHugoton Pool
NORTH

KANSAS

Finney

Sec. 10 Twp. 26 R. 34W

Well No. #2 Government Farm

Helmerich & Payne Company

Hugoton

 Ft. from N. Line


2640 Ft. from S. Line

660
2640 Ft. from E. Line

 Ft. from W. Line

~~C Sec.~~

C E 1/2 E 1/2 Sec.

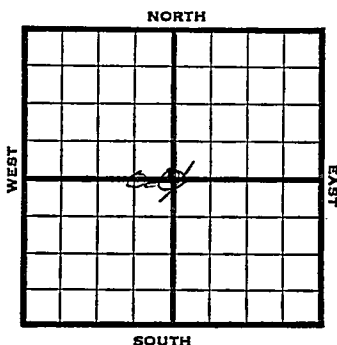

1948

Elev. 2963' REPORT

4/7

10" @ 528'
7" @ 2526'
TD 2540'
WOC

4/14

TD 2583'
300 Acid
Drlg. 2647'

4/21

TD 2706'
186' of 5" Perf liner @ 2706'
15,000 Acid

4/28

"

5/5

7" @ 2526'
186' of 5" Perf liner @ 2706
Gas, 12,530,000
R. Pr. 410#
TD 2706'

COMPLETED

Map No. _____ Sec. 10 Twp. 26 R. 34W

Well No. 2 Government

Helmerich & Payne Company

FIRST REPORT Contractor

C Sec.


_____ Ft. from N. Line

2640 Ft. from S. Line

2640 Ft. from E. Line

_____ Ft. from W. Line

SECTION PLAT

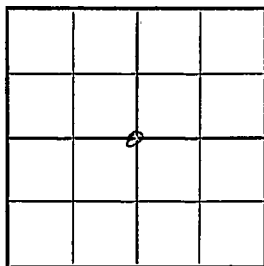

Finney County

Location _____

Rig up _____

Drilling and Remarks:

10" @ 528

7" @ 2526

TD 2540 WOC

RECORD

Cased _____ in., _____ ft.

Sand _____

Gas _____

Oil _____

Total Depth _____

PRODUCTION

1st 24 hrs. Nat. _____

1st 24 hrs. after shot _____

Gas _____ Cu. Ft.

Dry Hole _____

Abandoned _____

Date

APR 7 1948 19 S. J. LEWIS Scout

No Map
Map No. _____ Sec. 10 Twp. 26 R. 34WWell No. 2 GovernmentHelmerich & Payne


Company

CORRECTION

Contractor

C $E\frac{1}{2}$ $E\frac{1}{2}$ Sec.

SECTION PLAT

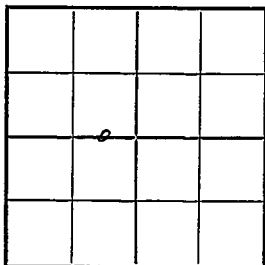

_____ Ft. from N. Line

2640 Ft. from S. Line660 Ft. from E. Line

_____ Ft. from W. Line

Finney County

Location _____

Rig up _____

Drilling and Remarks:

Reported C Sec.

RECORD

Cased _____ in., _____ ft.

Sand _____

Gas _____

Oil _____

Total Depth _____

PRODUCTION

1st 24 hrs. Nat. _____

1st 24 hrs. after shot _____

Gas _____ Cu. Ft.

Dry Hole _____

Abandoned _____

Date

APR 28 1948 19

S. J. LEWIS

Scout

Map No. _____ Sec. 10 Twp. 26 R. 34W

Well No. 2 Government

Helmerich & Payne Company

C E₂ W₂ Sec. **COMPLETE** Contractor


E 12968
SECTION PLAT

_____ Ft. from N. Line

2640 Ft. from S. Line

660 Ft. from E. Line

_____ Ft. from W. Line

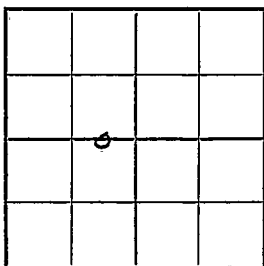

Finney County

Location _____

Rig up _____

Drilling and Remarks:

7' C2526.
186' x 15' Pay lines
C2706
15000' sand
12,530,000' Gas
410' R/A

RECORD

Cased _____ in., _____ ft.

Sand _____

Gas _____

Oil _____

Total Depth 2706

PRODUCTION

1st 24 hrs. Nat. _____

1st 24 hrs. after shot _____

Gas _____ Cu. Ft.

Dry Hole _____

Abandoned _____

Date

MAY 5 1948 19 S. J. LEWIS Scout