



81

STATE CORPORATION COMMISSION OF KANSAS
OIL & GAS CONSERVATION DIVISION

WELL COMPLETION OR RECOMPLETION FORM
ACO-1 WELL HISTORY

DESCRIPTION OF WELL AND LEASE

Operator: License # 5087
Name Texas Energies, Inc.
Address P.O. Box 947
City/State/Zip Pratt, KS 67124

Purchaser N.F. McKe...

Operator Contact Person Brian G. Fisher
Phone (316) 263-4777

Contractor: License # 5149
Name Wheatstate Oilfield Services

Wellsite Geologist Scott Alberg
Phone (316) 672-5729

Designate Type of Completion
 New Well Re-Entry Workover
 Oil SWD Temp Abd
 Gas Inj Delayed Comp.
 Dry Other (Core, Water Supply etc.)

If OWWO: old well info as follows:
Operator
Well Name
Comp. Date Old Total Depth

WELL HISTORY

Drilling Method:
 Mud Rotary Air Rotary Cable
3-07-85 3-17-85 6-05-85
Spud Date Date Reached TD Completion Date
4350 4319
Total Depth PBTD

Amount of Surface Pipe Set and Cemented at 478 feet
Multiple Stage Cementing Collar Used? Yes No
If yes, show depth set...feet
If alternate 2 completion, cement circulated from...feet depth to...w/...SX cmt

API NO. 15-151-21,585
County Pratt
SE NW SW Sec. 26 Twp. 26S Rge. 11 East West

1650 Ft North from Southeast Corner of Section
4290 Ft West from Southeast Corner of Section
(Note: Locate well in section plat below)


Lease Name Young Well # 1-26

Field Name Haynesville East

Producing Formation

Elevation: Ground 1807 KB 1812

Section Plat

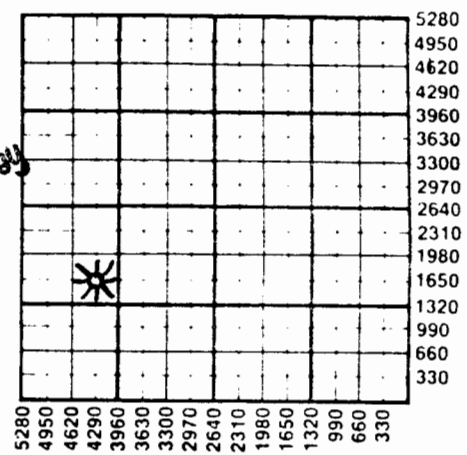

SEP 03 1985
State Geological Survey
WICHITA BRANCH

WATER SUPPLY INFORMATION

Disposition of Produced Water: Disposal Repressuring
Docket #

Questions on this portion of the ACO-1 call:

Water Resources Board (913) 296-3717

Source of Water:
Division of Water Resources Permit # T85-253

Groundwater 1650 Ft North from Southeast Corner (Well) 4290 Ft West from Southeast Corner of Sec 26 Twp 26S Rge 11 East West

Surface Water...Ft North from Southeast Corner (Stream, pond etc)...Ft West from Southeast Corner Sec Twp Rge East West

Other (explain) (purchased from city, R.W.D. #)

INSTRUCTIONS: This form shall be completed in duplicate and filed with the Kansas Corporation Commission, 200 Colorado Derby Building, Wichita, Kansas 67202, within 90 days after completion or recompletion of any well. Rule 82-3-130 and 82-3-107 apply. Information on side two of this form will be held confidential for a period of 12 months if requested in writing and submitted with the form. See rule 82-3-107 for confidentiality in excess of 12 months. One copy of all wireline logs and drillers time log shall be attached with this form. Submit CP-4 form with all plugged wells. Submit CP-111 form with all temporarily abandoned wells.