

2175
SIDE ONE

STATE CORPORATION COMMISSION OF KANSAS
OIL & GAS CONSERVATION DIVISION
WELL COMPLETION FORM
ACO-1 WELL HISTORY
DESCRIPTION OF WELL AND LEASE

API NO. 15- 151-22,041

County Pratt

SW NW NE Sec. 5 Twp. 26 Rge. 11 East West

990' Ft. ~~North~~ North from ~~Southeast~~ Southwest Corner of Section North Line (Irregular)

2310' Ft. West from Southeast Corner of Section
(NOTE: Locate well in section plat below.)

Lease Name Rundell Well # 6

Field Name Bauman

Producing Formation Mississippi Chert

Elevation: Ground 1842 KB 1850

Total Depth 4165' PBDT _____

Operator: License # 5046

Name: Raymond Oil Company, Inc.

Address P.O. Box 48788

City/State/Zip Wichita, KS 67201

Purchaser: PERMIAN

Operator Contact Person: William S. Raymond

Phone (316) 267-4214

Contractor: Name: Duke Drilling Co., Inc. RECEIVED

License: 5929

Wellsite Geologist: Tim Hellman APR 26 1991

Designate Type of Completion
 New Well Re-Entry Workover Wichita Kansas

Oil SWD Temp. Abd.
 Gas Inj Delayed Comp.
 Dry Other (Core, Water Supply, etc.)


If OWMO: old well info as follows:
Operator: _____

Well Name: _____

Comp. Date _____ Old Total Depth _____

Drilling Method:
 Mud Rotary Air Rotary Cable

03-19-91 03-26-91 4-17-91
Spud Date Date Reached TD Completion Date

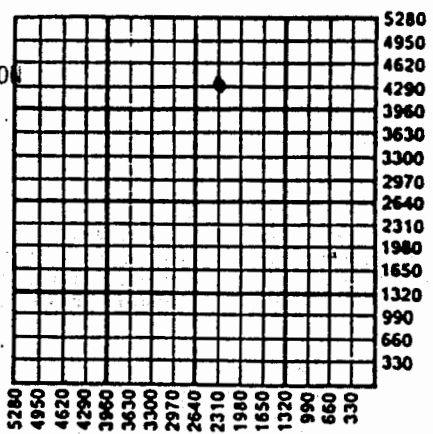

Amount of Surface Pipe Set and Cemented at 244' Feet

Multiple Stage Cementing Collar Used? Yes No

If yes, show depth set _____ Feet

If Alternate II completion, cement circulated from _____
feet depth to _____ w/ _____ sx cmt.

INSTRUCTIONS: This form shall be completed in triplicate and filed with the Kansas Corporation Commission, 200 Colorado Derby Building, Wichita, Kansas 67202, within 120 days of the spud date of any well. Rule 82-3-130, 82-3-107 and 82-3-106 apply. Information on side two of this form will be held confidential for a period of 12 months if requested in writing and submitted with the form. See rule 82-3-107 for confidentiality in excess of 12 months. One copy of all wireline logs and drillers time log shall be attached with this form. ALL CEMENTING TICKETS MUST BE ATTACHED. Submit CP-4 form with all plugged wells. Submit CP-111 form with all temporarily abandoned wells. Any recompletion, workover or conversion of a well requires filing of ACO-2 within 120 days from commencement date of such work.

All requirements of the statutes, rules and regulations promulgated to regulate the oil and gas industry have been fully complied with and the statements herein are complete and correct to the best of my knowledge.

Signature Pat Raymond
Title Vice President Date 4/25/91

Subscribed and sworn to before me this 25th day of April, 1991.

Notary Public Sharon A. Hill

Date Commission Expires 4-25-91



K.C.C. OFFICE USE ONLY
F Letter of Confidentiality Attached
C Wireline Log Received
C Drillers Timelog Received

Distribution
 KCC SMD/Rep NGPA
 KGS Plug Other (Specify) J.S.