


6-26-11 W

WELL LOG BUREAU - KANSAS GEOLOGICAL SOCIETY
412 Union National Bk. Bldg., Wichita, Kansas

Company - PULSE-HERSHFIELD DRIG. CO., INC.
Farm - Block No. 1

SEC. 6 T. 26 R. 11 W
SE NE NW

Total Depth. 4329'
Comm. 6-5-46 Comp. 7-31-46
Shot or Treated.
Contractor.
issued. 8-31-46

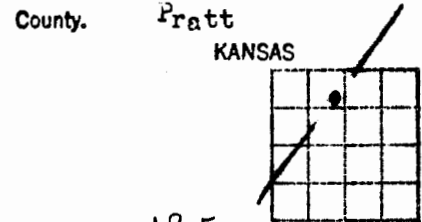

CASING:
10 3/4" 282' Cem.

Elevation. 1851 *rh*
Production. Dry

Figures Indicate Bottom of Formations.

surface & sand	75
sand	165
shale red	230
sand	245
red rock	627
anhydrite	650
shale & shells	815
sand brkn	1040
shale & shells	1082
shale	1112
shale & shells	1320
shale & salt	1524
shale & shells	1690
lime	1822
lime brkn	1970
lime	2102
lime brkn	2300
shale & shells	2795
lime	2840
lime brkn	2985
lime	3215
lime brkn	3305
lime	3380
lime brkn	3485
shale	3580
lime	3635
lime brkn	3706
lime	3765
lime brkn	3863
lime	3888
lime brkn	3939
lime Miss.	3949
lime cherty	3991
shale	4108
lime cherty	4135
lime	4190
shale & shells	4230
shale	4266
sand	4291

Arbuckle dolomite	4329
Total Depth.	
Tops:	
Kansas City	3558
Mississippi	3932
Viola	4108
Simpson Shale	4230
Simpson Sand	4266
Arbuckle	4291