

Pratt County ✓

Sec. 6 **KANSAS** Twp. 26 R. 11W

Well No. #1 Block Farm _____

Pulse et al Company _____

Wildcat


_____ Ft. from N. Line

1650 Ft. from S. Line

330 Ft. from E. Line

_____ Ft. from W. Line

SE NE NW

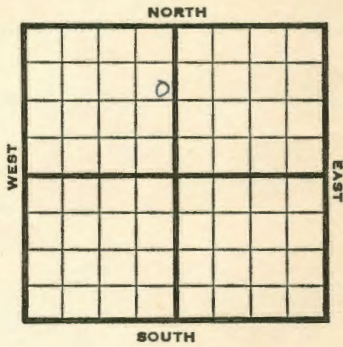

1946 **Elev. 1851** REPORT

- 5/22 Location
- 5/29 "
- 6/5 "
- 6/12 10" @ 175'
Drlg 1560'
- 6/18 Drlg 2575'
- 6/26 Drlg 3365'
- 7/3 **Lans 3580'**
Miss 3939'
Drlg 3949'
- 7/9 **Viola 4106'**
TD 4153 S
- 7/16 **Simp sd 4187'**
4266 fsg
- 7/23 " "
- 7/30 Drlg 4276'
- 8/7 **Arb. 4291'**
TD 4328'

ABANDONED


KANSAS

Pratt

Section 6 Township 26 Range 11W

Well No. 1 Block

Company Pulse et al

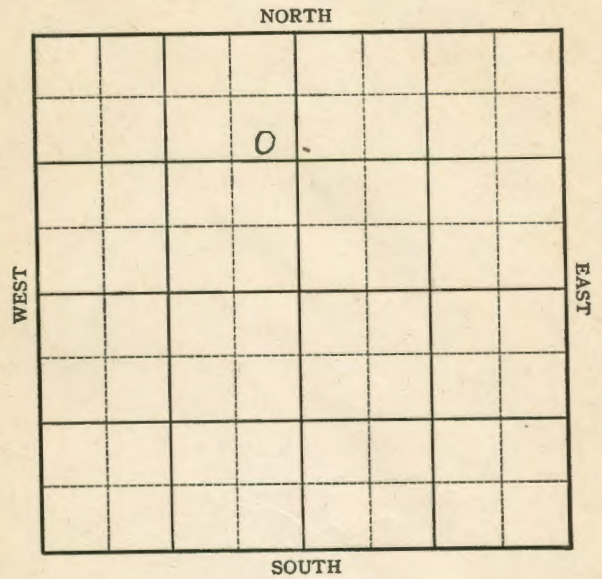

Kansas Pool Name Wildcat

KANSAS Map No. 117 Sec. 6 Twp. 26 R. 11W

Well No. 1 Block

Pulse etal Company

FIRST REPORT Contractor

SE NE NW

SECTION PLAT

| | | | |
|--|---|--|--|
| | | | |
| | o | | |
| | | | |
| | | | |
| | | | |

_____ Ft. from N. Line

1650 Ft. from S. Line

330 Ft. from E. Line

_____ Ft. from W. Line

Pratt County

Location X

Rig up _____

Drilling and Remarks:

RECORD

Cased _____ in., _____ ft.

Sand _____

Gas _____

Oil _____

Total Depth _____

PRODUCTION

1st 24 hrs. Nat. _____

1st 24 hrs. after shot _____

Gas _____ Cu. Ft.

Dry Hole _____

Abandoned _____

Date _____

MAY 22 1946 19

S. J. LEWIS Scout

Kansas Pool Name Wildcat

KANSAS Map No. 47 Sec. 6 Twp. 26 R. 11W

Well No. 1 Block

Pulse etal Company

ABANDONED Contractor

SE NE NW

E. 11701
SECTION PLAT

| | | | |
|--|---|--|--|
| | | | |
| | o | | |
| | | | |
| | | | |
| | | | |

_____ Ft. from N. Line

1650 Ft. from S. Line

330 Ft. from E. Line

_____ Ft. from W. Line

Pratt County

Location _____

Rig up _____

Drilling and Remarks:

Cur 4291

RECORD

Cased _____ in., _____ ft.

Sand _____

Gas _____

Oil _____

Total Depth 4328

PRODUCTION

1st 24 hrs. Nat. _____

1st 24 hrs. after shot _____

Gas _____ Cu. Ft.

Dry Hole _____

Abandoned _____

Date _____

AUG 7 1946 19

S. J. LEWIS Scout