

KANSAS


FORM 51 5M 1-42 PETROL

Pratt

Section 7 Township 26 Range 11-W

Well No. #2 Moeller

Company Lion Oil & Refining

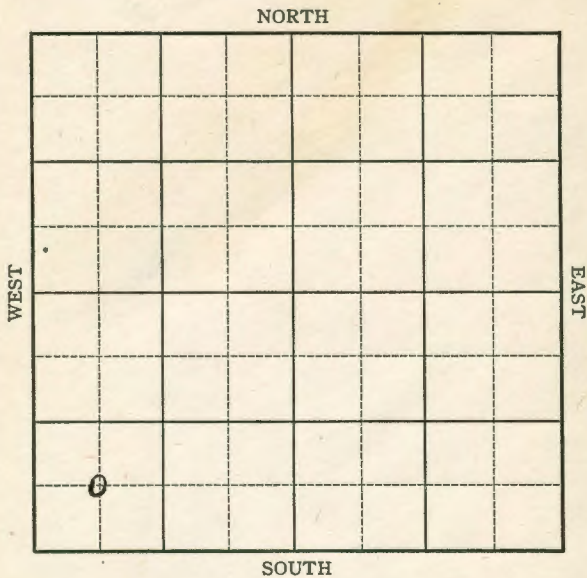

FORM 252-A  
5M 9-42 GASS

KANSAS

Pratt

Sec. 7 Twp. 26 R. 11-W

Well No. #2 Moeller Farm

Lion Oil & Refining Company

Stark North


\_\_\_\_\_ Ft. from N. Line

660 Ft. from S. Line

\_\_\_\_\_ Ft. from E. Line

660 Ft. from W. Line

Elev. 1862

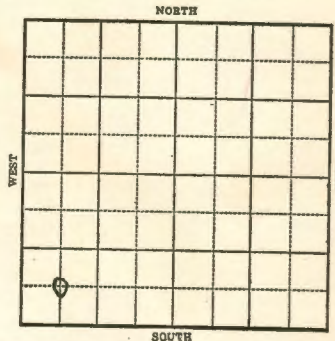

1943

REPORT

- 6/2 Location.
- 6/9 Rotary
- 6/16 Rotary
- 6/23 82 @ 298'  
Drlg. 3740'
- 6/30 **Viola 4147051** T.D.  
600' oil  
5" @ 4147 Rust
- 7/7 HFO in 11/3 hrs-500 acid
- 7/14 **Viola 4147**  
5" @ 4147  
T.D. 4151'  
500 acid  
Bomb Pot 32292  
Max. 3000  
Gravity 49.9

**COMPLETED**

Pratt

KANSAS

Map No. 7 Sec. 7 Twp. 26 R. 11W

Well No. 2 Moeller

Lion Oil & Refining Company

FIRST REPORT Contractor

C SW SW

SECTION PLAT

Ft. from N. Line

660

Ft. from S. Line

Ft. from E. Line

660

Ft. from W. Line

o			

STARK NORTH POOL

Location XXX

RECORD

Cased \_\_\_\_\_ in., \_\_\_\_\_ ft.

Sand \_\_\_\_\_

Gas \_\_\_\_\_

Oil \_\_\_\_\_

Total Depth \_\_\_\_\_

PRODUCTION

1st 24 hrs. Nat. \_\_\_\_\_

1st 24 hrs. after shot \_\_\_\_\_

Gas \_\_\_\_\_ Cu. Ft.

Dry Hole \_\_\_\_\_

Abandoned \_\_\_\_\_

Date

JUN 2 1943<sub>19</sub>

S. J. LEWIS Scout

Pratt

Map No. 47 Sec. 7 Twp. 26 R. 11W

Well No. 2 Moeller

Lion Oil Refining Company

COMPLETED Contractor

C SW SW

SECTION PLAT

Ft. from N. Line

660

Ft. from S. Line

Ft. from E. Line

660

Ft. from W. Line

o			

STARK NORTH POOL

Location \_\_\_\_\_

RECORD

Cased \_\_\_\_\_ in., \_\_\_\_\_ ft.

Sand \_\_\_\_\_

Gas \_\_\_\_\_

Oil \_\_\_\_\_

Total Depth 4151

PRODUCTION

1st 24 hrs. Nat. \_\_\_\_\_

1st 24 hrs. after shot \_\_\_\_\_

Gas \_\_\_\_\_ Cu. Ft.

Dry Hole \_\_\_\_\_

Abandoned \_\_\_\_\_

Date

JUL 14 1943<sub>19</sub>

S. J. LEWIS Scout

*Viola 4147*  
*5" c 4147*  
*500 acid*  
*Ann + P 432292*  
*May 3000*  
*405 M*