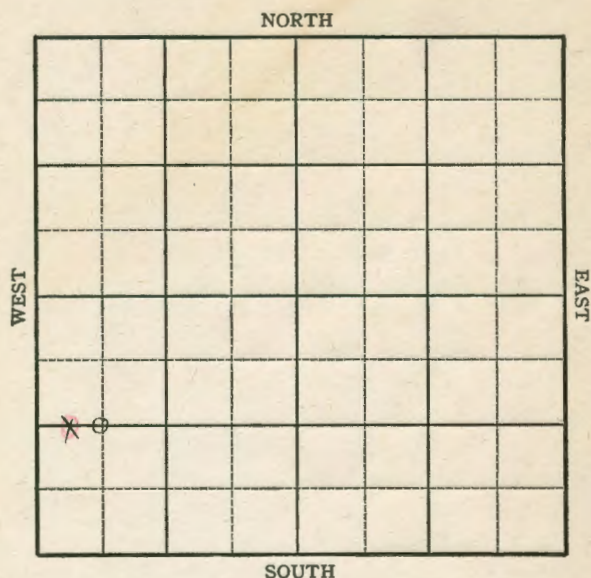


KANSAS Pratt

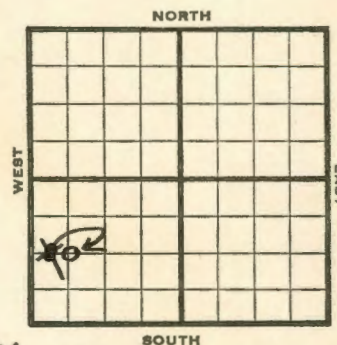
Section 7 Township 26 Range 11WWell No. 3 MoellerCompany Lion Oil

KANSAS Pratt

Sec. 7 Twp. 26 R. 11-WWell No. #3 Moeller FarmLion Oil Company1320 Ft. from N. Line

Ft. from S. Line

Ft. from E. Line

660
330 Ft. from W. Line~~C W L SW~~ C W/2 SW

1945 Elev. 1861 REPORT

9/26 Location

10/3 9" @ 320

Drlg. 1400'

10/10 Drlg. 2800'

10/17 Drlg. 3617'

10/24 Drlg. 4000

10/31 **Viola 4153**

TD 4154

5" @ 4153 RUST

11/7 **Viola 4145 corrected**

5" @ 4148

TD 4151' swab 60 oil in 16 hrs.

11/14 500 acid.

Flow 45 oil in 5½ hrs.

11/21 " " " "

11/28 " " " "

12/5 **Viola 4145**

5" @ 4148

TD 4151

Flow 89 Pot.

Grav. 40.0

COMPLETED

KANSAS

Kansas Pool Name Stark North
 Map No. 47 Sec. 7 Twp. 26 R. 11W
 Well No. 3 Moeller

Lion Oil

Company

CORRECTION

Contractor

C W $\frac{1}{2}$ SW

SECTION PLAT

1320 Ft. from N. Line

Ft. from S. Line

Ft. from E. Line

660 Ft. from W. Line

Pratt County

Location

Rig up

Drilling and Remarks:
reported C W L SW

RECORD

Cased in, ft.

Sand

Gas

Oil

Total Depth

PRODUCTION

1st 24 hrs. Nat.

1st 24 hrs. after shot

Gas Cu. Ft.

Dry Hole

Abandoned

Date

OCT 17 1945

S. J. LEWIS Scout

KANSAS

Kansas Pool Name Stark North
 Map No. 47 Sec. 7 Twp. 26 R. 11W
 Well No. 3 Moeller

Lion Oil

Company

FIRST REPORT

Contractor

C W L SW

SECTION PLAT

1320 Ft. from N. Line

Ft. from S. Line

Ft. from E. Line

330 Ft. from W. Line

Pratt County

Location

Rig up

Drilling and Remarks:

RECORD

Cased in, ft.

Sand

Gas

Oil

Total Depth

PRODUCTION

1st 24 hrs. Nat.

1st 24 hrs. after shot

Gas Cu. Ft.

Dry Hole

Abandoned

Date

SEP 26 1945

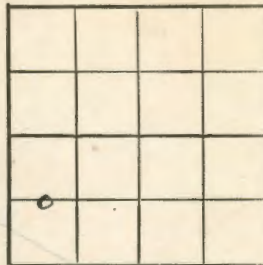
S. J. LEWIS Scout

KANSASKansaPool Name Stark NorthMap No. K-47 Sec. 7 Twp. 26 R. 11WWell No. 3 MoellerLion Oil

Company

COMPLETED

Contractor

C $W\frac{1}{2}$ SWE. J. R. /
SECTION PLAT1320 Ft. from N. Line Ft. from S. Line Ft. from E. Line660 Ft. from W. LinePratt CountyLocation Rig up

Drilling and Remarks:

Viola 445'5' C 4 1/4"Flow 89 Bbl40 2 1/2**RECORD**Cased in., ft.Sand Gas Oil Total Depth 445'**PRODUCTION**1st 24 hrs. Nat. 1st 24 hrs. after shot Gas Cu. Ft.Dry Hole Abandoned

Date

DEC 5 1945 19S. J. LEWIS Scout