

Sec. 5 Twp. 26 R. 11W **Pratt KANSAS** ✓

Well No. #1 Jorns Farm _____

Helmerich & Payne, Inc. Company _____

Peel Bros. Contractor _____

Wildcat

_____ Ft. from N. Line

330 _____ Ft. from S. Line

_____ Ft. from E. Line

330 _____ Ft. from W. Line

SW SW NW

Magnolia - acreage

Skelly - DHM

1953 **Elev. 1851'** REPORT


5/6 Spud 4-30-53
8" @ 534, WOC

5/21 Drlg 3130'

5/28 **Heeb 3400, Br 1i 3580, Lans 3607**
DST 3700-3725, 1 hr., 150' W, 1220#
Cong 3965, Miss 3980
Drlg. 4020

6/3 Spud 4-30-53
D&A
TD 4354
8" @ 534
Heeb 3400, Tor 3415, Br lime 3580,
Lans 3607
DST 3700-25, opn 1 hr., rec. 150' wtr.,
1220#
Cong 3965, Miss 3980
DST 4120-34, opn $\frac{1}{2}$ hrs., rec. 10' mud
DST 4135-65, opn $\frac{1}{2}$ hrs., rec. 10' mud
DST 4281-91, opn 1 hr., rec. 5' mud,
250#
Viola 4121, Simp 4219, Arb. 4302
TD 4354
D&A

ABANDONED

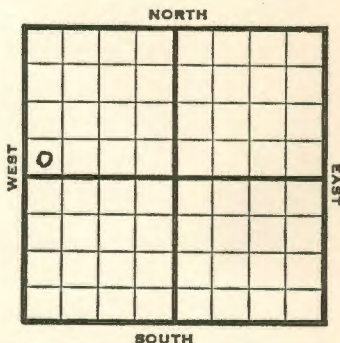

Section 5 Township 26 Range 11W **Pratt KANSAS**

Well No. #1 Jorns

Company Helmerich & Payne, Inc.

