

Sec. 6 Twp. 26 R. 11W

Well No. #1 Schlentz Farm

Skelly Oil Company

Stark Pool Contractor


Ft. from N. Line

330' Ft. from S. Line

330' Ft. from E. Line

Ft. from W. Line

SE SE SW

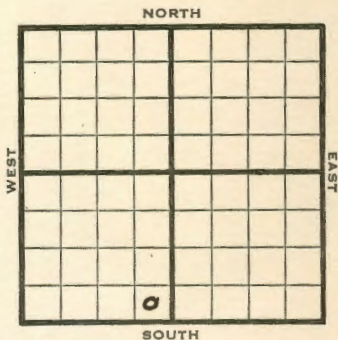

1950 **Elev. 1858'** REPORT

8/16 Location

9/20 Spud 8-22-50

D&A TD 4338'

8" @ 433'

Lans. 3608' Kinderhook 4104'

Viola 4133'

Miss 3975'

DST 4135-50 opn 50 min

Rec. 90' mud

DST 4154-65 opn 1 hr

Rec. 70' mud & wtr SSO

Simp Sd 4230'

Arb. 4313-38 TD

D&A **ABANDONED**

Section 6 Township 26 Range 11-W

Well No. #1 Schlentz

Company Skelly Oil

