FORM 252-A
5M 9-42 GASS

KANSAS

Pratt

Sec. 7 Twp. 26 R. 11-W

Well No. #1 Moeller Farm

Transwestern Company


660 Ft. from N. Line

Ft. from S. Line

800 Ft. from E. Line

Ft. from W. Line

Stark North Pool

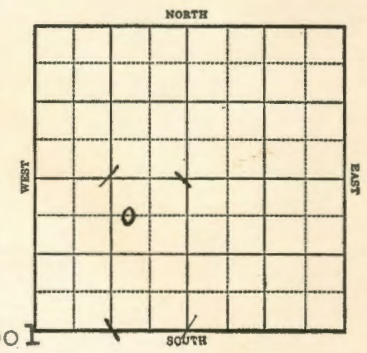

1943	Elev. 1858 REPORT
7/28	Surface Hole
8/4	10" @ 620' Anhy 648 Drlg. 2000'
8/11	Lans 3615 Drlg. 3652'
8/18	4095 fsg
8/25	Viola 4165 Water T.D. 4174'
	ABANDONED

KANSAS


FORM 51 5M 1-42 PETROL

Pratt

Section 7 Township 26 Range 11-W

Well No. #1 Moeller

Company Transwestern

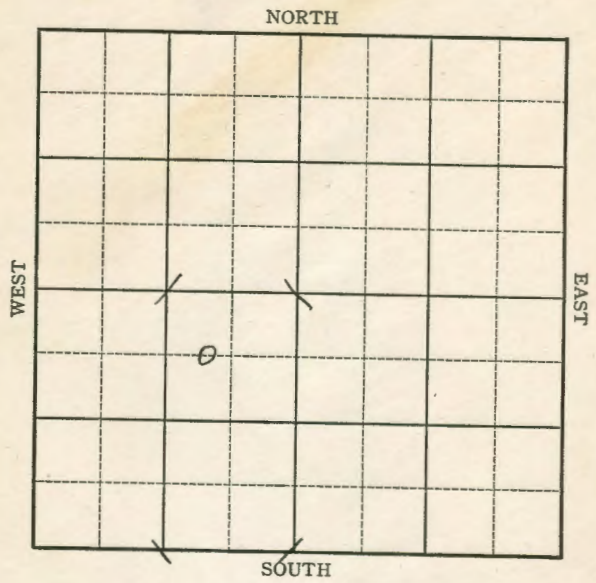

Form 26 200 Bks 5-42 Petrol Pratt

KANSAS

Map No. 47 Sec. 7 Twp. 26 R. 11W

Well No. 1 Moeller

Transwestern Company

ABANDONED Contractor

C W L NE SW

660 Ft. from N. Line


Ft. from S. Line

800 Ft. from E. Line

Ft. from W. Line

Stark North Pool

SECTION PLAT

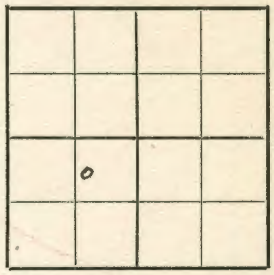

Location

Rig up

Drilling and Remarks:

Viola 4165

Water

RECORD

Cased in., ft.

Sand

Gas

Oil

Total Depth 4124

PRODUCTION

1st 24 hrs. Nat.

1st 24 hrs. after shot

Gas Cu. Ft.

Dry Hole

Abandoned

Date

AUG 25 1943 19

S. J. LEWIS Scout

Form 26 200 Bks 5-42 Petrol Pratt

KANSAS

Map No. 47 Sec. 7 Twp. 26 R. 11W

Well No. 1 Moeller

Transwestern Company

FIRST REPORT Contractor

C WL NE SW

660 Ft. from N. Line


Ft. from S. Line

800 Ft. from E. Line

Ft. from W. Line

STARK NORTH POOL

SECTION PLAT

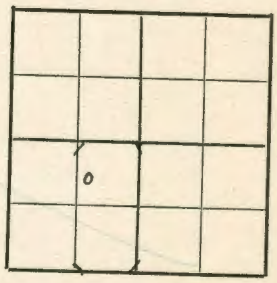

Location

Rig up

Drilling and Remarks:

Surface Hole

RECORD

Cased in., ft.

Sand

Gas

Oil

Total Depth

PRODUCTION

1st 24 hrs. Nat.

1st 24 hrs. after shot

Gas Cu. Ft.

Dry Hole

Abandoned

Date

JUL 28 1943 19

S. J. LEWIS Scout