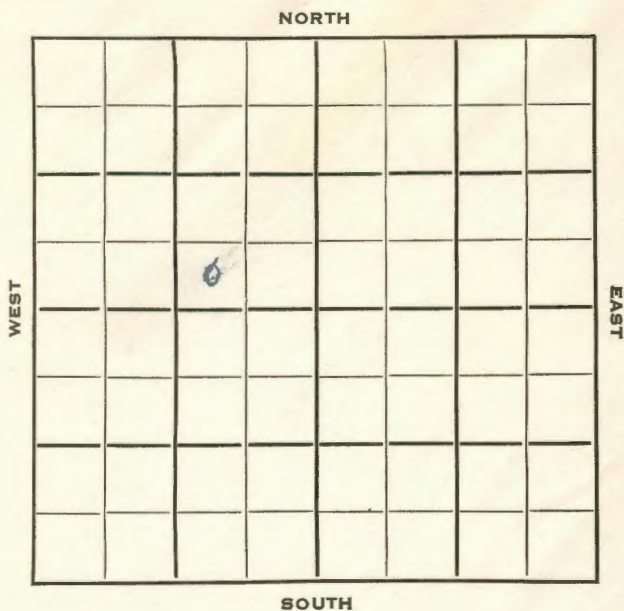


FORM 51

Pratt KANSAS

Section 16 Township 26 Range 11 WWell No. # 1 ShriverCompany Natural Gas & Oil


Pratt KANSAS

SEC. <u>16</u>	TWP. <u>26</u>	R. <u>11W</u>
----------------	----------------	---------------

WELL NO. <u>1 Shriver</u>	FARM
---------------------------	------

COMPANY <u>Natural Gas & Oil</u>	
--------------------------------------	--

CONTRACTOR <u>Co. Tools Wildcat</u>	
-------------------------------------	--

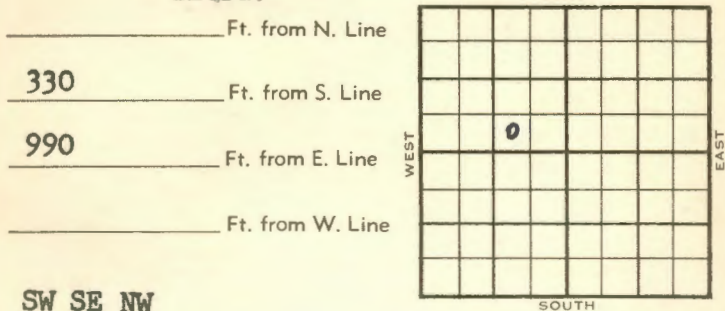

_____ Ft. from N. Line

330 _____ Ft. from S. Line

990 _____ Ft. from E. Line

_____ Ft. from W. Line

SW SE NW

ELEVATION	REPORT
<u>1954</u>	<u>1839'</u>

4/21 MIR

5/5 10" @ 385'

Anhy 600', Heeb 3414', Doug 3496'

Br. L. 3591', Lans 3617'

DST 3672'-3708' 1 hr, 60' gas, 45' so & gcm

DST 3714'-42' 1 hr, 242' so & gcw 1320#

DST 3764'-3800' 1 hr, 30' SOCM, 135#

Cong 4015', Miss 4038'

Drlg 4115'.

5/12 Spud 4-22-54

D & A

TD 4463'

10" @ 385'

Anhy 600', Heeb 3414', Doug 3496'

Br. Lime 3591', Lans 3617',

DST 3672'-3708' opn 1 hr, rec 60' gas 45' so & gcm

DST 3714'-42' opn 1 hr, rec 242' so & gcw, 1320#

DST 3764'-3800' opn 1 hr, rec 30' socm 135#

Cong 4015', Miss 4038', Kh 4130'

Viola 4245', Simp 4349',

DX-78

OVER

FORM 275 FOR SALE BY KANSAS BLUE PRINT CO.

County **Pratt** State **Kansas**
 Sec. **16** (Blk. Twp.) **26** (Sur. Rge.) **11W** Map No.
 Operator **Natural Gas & Oil**
 Well No. **1** Farm **Shriver**

Elev. Location **SW SE NW**
330 Ft. From **S** Line **NW**
990 Ft. From **E** Line Quarter
 1st. Report **APR 21 1954**
 Completion
 Remarks
Co. tools
 Spudding Date

Drig. Data **Wildcat**
MIR

J. G. McGEHEE


1954

Information brought forward.

5/12

DST 4335'-73' opn 1 hr, rec 10' Mud
 175# Arb 4409'
 TD 4463'
 D & A

ABANDONED

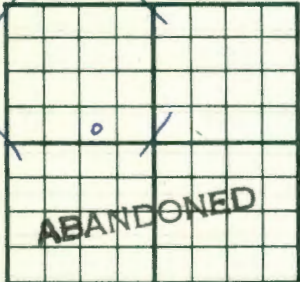County	Pratt		State	Kansas		
Sec.	16	(Blk. Twp.)	26	(Sur. Rge.)	11W Map No.	
Operator	Natural Gas & Oil					
Well No.	1	Farm	Shriver			
Elev.	1839	Location	SW SE NW			
		330 Ft. From	S Line	NW		
		990 Ft. From	E Line	Quarter		
		1st. Report				
		Completion	MAY 12 1954			
		Remarks	Wildcat			
		Co. tools				
		Spudding Date	4-22-54			
Drig. Data	D & A		TD 4463			
10" @ 385 Anhy 600 Heeb. 3414						
Doug. 3496 Br. line 3591 Lans. 3617						
DST 3672-3708 open 1 hr. Rec. 60' gas						
45' so & gcm DST 3714-42 open 1 hr.						
Rec. 242' so & gcw 1320# DST 3764-3800						
open 1 hr. Rec. 30' soem 135#						
Cong. 4015 Miss. 4038 Kh. 4130						
Viola 4245 Simp. 4349 DST 4335-73						
open 1 hr. Rec. 10' mud 175#						
Arb. 4409 TD 4463						
D & A 4409						

J. G. McGEHEE