


Section 18 Township 26 Range 11W

Well No. #1 Embree

Company C R A

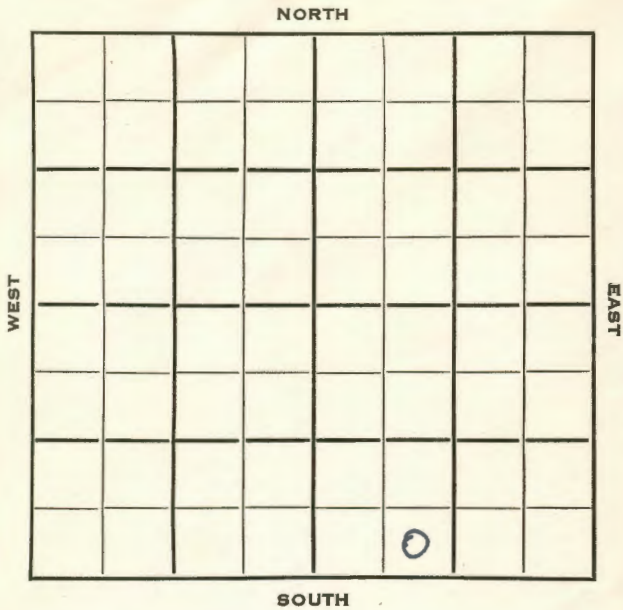

Sec. 18 Twp. 26 R. 11W

Well No. #1 Embree Farm _____

C.R.A. Company _____

C.R.A. Contractor _____
Wildcat.


_____ Ft. from N. Line

330 Ft. from S. Line

_____ Ft. from E. Line

990 Ft. from W. Line

SE SW SE

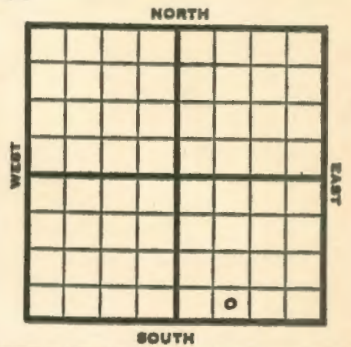

1953

Elev. 1860' REPORT

7/22

Spud 7-18-53
8" @ 482'
Drlg 1810'

7/29

Heeb 3430 Tor 3444 Doug 3470
Br 11 3612 Lans 3639
Drlg. 3730'

8/5

DST 3736-66 1 hr, 275' sw 1270#
Miss 4031
DST 4180-98 1/2 hr, 25' socm 30#
DST 4257-61 1 hr, 360' gas, 120' o&gcm
90' ocm 753#
Kh 4109, V. 4256, Simp 4360
Coring 4367'

8/12

Spud 7-18-53
D&A
TD 4488
8" @ 482'
Heeb 3430, Tor 3444, Doug 3470, Br
line 3612, Lans 3639
DST 3736-66, opn 1 hr., rec. 275' SW
1270#
Miss 4031
~~DST 3736-66, opn 1 hr., rec. 275' SW~~
DST 4080-98, opn 1/2 hrs., rec. 25'
socm, 30#
DST 4257-61, opn 1 hr., rec. 360'
gas, 120' o & gcm, 90' gcm, 753#

OVER

