

KANSAS Pratt

Sec. 18 Twp. 26 R. 11-W

Well No. #1 Stark Farm

A. D. Allison Company

Contractor

Stark


Ft. from N. Line

330 Ft. from S. Line

Ft. from E. Line

660 Ft. from W. Line

C S L SW NW

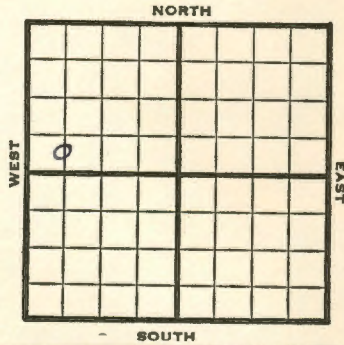

1950 Elev 1861 REPORT

12/13 Location

1951 1/10 Spud 12-8-50
8" @ 330

Toronto 3425 Douglas 3442

Lans 3607 Viola 4055

DST 4052-77 opn 1/2 hr rec 390' so & gcm
90' wtr

Simp 4154

DST 4177-4214 opn 45 min rec 8' mud

Arb 4228

DST 4228-36 opn 1 hr rec 37' o&gcm

DST 4238-78 opn 1/2 hr rec 600' gcm

& wtr SSO

TD 4288

D&A

ABANDONED

Pratt

KANSAS

Section 18 Township 26 Range 11W

Well No. #1 Stark

Company A. D. Allison

