FORM 252-A
5M 10-48 PETROL

KANSAS Pratt

Sec. 18 Twp. 26 R. 11W ✓

Well No. #1 Stark Farm

Huber Company

Stark Pool


____ Ft. from N. Line

330' Ft. from S. Line

____ Ft. from E. Line

330' Ft. from W. Line

SW NW

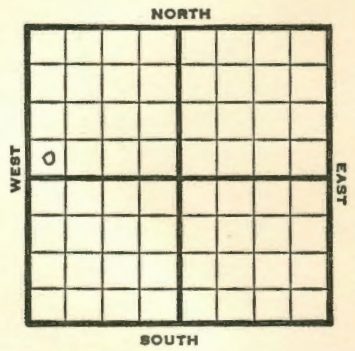

1948	Elev 1862' REPORT
10/27	Location
11/3	RUR
11/10	10"@ 347'
11/16	Drlg. 3385'
11/23	Drlg 3996'
11/30	Drlg 4204'
12/6	Lansing 3599' B Miss 3983' Viola 4015' Simpson 4129' Arbuckle 4186' TD 4202 5" @ 4188'
12/14	500 acid Swb 1 bbl oil - PH
12/22	TD 4273' Acid 500
12/29	"
1/5	PB 4206' 25 qts 4195-4206'
1/12	"
1/19	"
1/26	53 shots 3796-3872 1000 acid Swb 5 fluid PH 95% W
2/2	TD 4273' Arb. 4186' 5"@ 4188' Abend.

ABANDONED

FORM 51 10M 7-48 PETROL


KANSAS Pratt

Section 18 Township 26 Range 11W

Well No. 1 Stark

Company Huber

Stark Pool

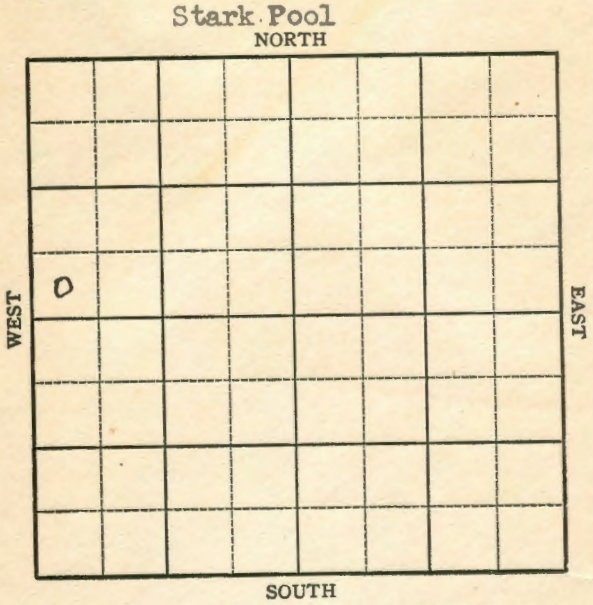

Form 26 200 Bks. 9-48 Petrol

Kansas

Stark Pool

Map No. ____ Sec. 18 Twp. 26 R. 11W


Well No. 1 Stark

Huber Company

FIRST REPORT Contractor

SW NW

SECTION PLAT

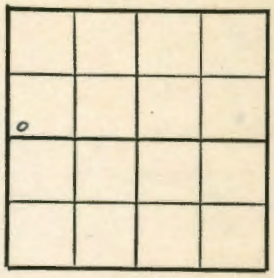

____ Ft. from N. Line

330 Ft. from S. Line

____ Ft. from E. Line

330 Ft. from W. Line

Pratt County

Location X

Rig up ____

Drilling and Remarks:

RECORD

Cased ____ in., ____ ft.

Sand ____

Gas ____

Oil ____

Total Depth ____

PRODUCTION

1st 24 hrs. Nat. ____

1st 24 hrs. after shot ____

Gas ____ Cu. Ft.

Dry Hole ____

Abandoned ____

Date

OCT 27 1948 19 S. J. LEWIS Scout

Form 26 200 Bks. 9-48 Petrol

Kansas

Stark Pool

Map No. 47 Sec. 18 Twp. 26 R. 11W

Well No. 1 Stark


Huber Company

ABANDONED Contractor

SW NW

E.1182

SECTION PLAT

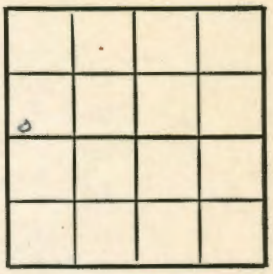

____ Ft. from N. Line

330 Ft. from S. Line

____ Ft. from E. Line

330 Ft. from W. Line

Pratt County

Location ____

Rig up ____

Drilling and Remarks:

Cer # 4182

5" C 4188

RECORD

Cased ____ in., ____ ft.

Sand ____

Gas ____

Oil ____

Total Depth 4279

PRODUCTION

1st 24 hrs. Nat. ____

1st 24 hrs. after shot ____

Gas ____ Cu. Ft.

Dry Hole ____

Abandoned ____

Date

FEB 2 1949 19 S. J. LEWIS Scout