

**KANSAS**

Pratt

Sec. 18 Twp. 26 R. 11-W

Well No. #1 Starks Farm

Atlantic Prod. Company


660 Ft. from N. Line

         Ft. from S. Line

         Ft. from E. Line

1840 Ft. from W. Line

*Elev. 1858*

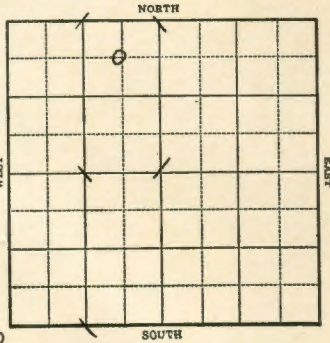

1943

REPORT

9/22	Location
9/29	"
10/6	Rotary
10/13	10" @ 386' WOB
10/20	2228' fsg.
10/27	" "
11/3	Whipstock 2100 Drlg. 2125'
11/10	Drlg. 2995
11/17	Drlg. 3778'
11/24	Drlg. 3987'
12/1	Lave 3619 Cong 4005 Miss 4023 kind 4072 Drlg 4173'
12/8	Viola 4491 TD 4201 7" @ 4196 RUST
12-15	" "
12/22	36 shots 4190-94 swb 6 bbls oil & 2 water per hr for 5 hrs.
12/29	" "


**OVER**

pratt

Section 18 Township 26 Range 11-W

Well No. #1 Starks

Company Atlantic Prod.

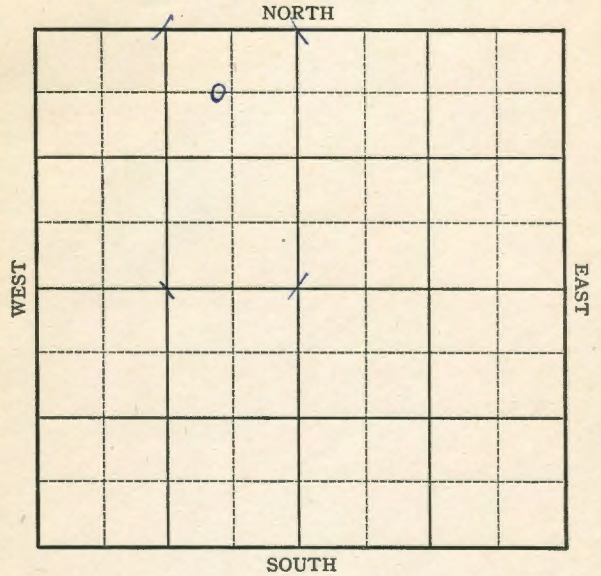

1944  
1-5 36 shots 3190-94 swb 6 oil  
plus 2 wtr per hr 5 hrs.

1-12

1/19

7" @ 4196

Viola 4191

TD 4201

36 shots 4190-94

Pump 202 Pot.

Gravity 37.8

**COMPLETED**

Form 26 200 Bks 5-42 Petrol Pratt

**KANSAS** 7 Sec. 18 Twp. 26 R. 11W

Well No. 1 Starks

Atlantic Prod. Company

FIRST REPORT Contractor

C NE NW


SECTION PLAT

660 Ft. from N. Line

Ft. from S. Line

Ft. from E. Line

1840 Ft. from W. Line

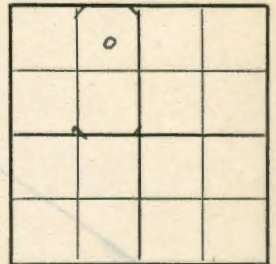

Stark Pool

Location X

Rig up

Drilling and Remarks:

RECORD

Cased in. ft.

Sand

Gas

Oil

Total Depth

PRODUCTION

1st 24 hrs. Nat.

1st 24 hrs. after shot

Gas Cu. Ft.

Dry Hole

Abandoned

Date

SEP 22 1943

19

S. J. LEWIS

Scout

Pratt

KANSAS

Map No. 47 Sec. 18 Twp. 26 R. 11W

Well No. 1 Stark

Atlantic Prod.

Company

COMPLETED

Contractor

C NE NW

SECTION PLAT

660 Ft. from N. Line

\_\_\_\_\_ Ft. from S. Line

\_\_\_\_\_ Ft. from E. Line

1840 Ft. from W. Line

	o		

Stark Pool

Location \_\_\_\_\_

Rig up \_\_\_\_\_

Drilling and Remarks:

*Viola 4191*  
*7" @ 4196*  
*36 1/2" @ 4190-94*  
*Pump 202 Pnt*  
*87 5/8*

RECORD

Cased \_\_\_\_\_ in., \_\_\_\_\_ ft.

Sand \_\_\_\_\_

Gas \_\_\_\_\_

Oil \_\_\_\_\_

Total Depth 4301

PRODUCTION

1st 24 hrs. Nat. \_\_\_\_\_

1st 24 hrs. after shot \_\_\_\_\_

Gas \_\_\_\_\_ Cu. Ft.

Dry Hole \_\_\_\_\_

Abandoned \_\_\_\_\_

Date \_\_\_\_\_

JAN 19 1944 19

S. J. LEWIS Scout