

KANSAS

Pratt

Sec. 18 Twp. 26 R. 11-W

Well No. #2 Stark Farm

Geo. Reeves et al Company


660 Ft. from N. Line

Ft. from S. Line

Ft. from E. Line

660 Ft. from W. Line

Stark Pool

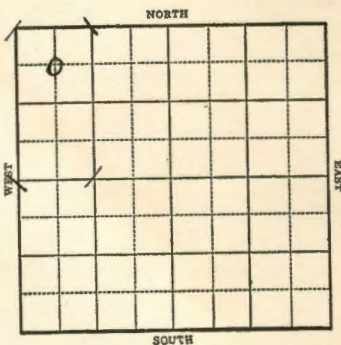

1943 Elev. 1860 REPORT

7/28	Location
8/4	Cellar
8/11	8" @ 319' Drilg. 2300'
8/18	Drilg. 3522'
8/25	Lans 3612 Viola 3146 T.D. 4150 5" @ 4147 Rust
9/1	" " "
9/8	T.D. 4149 flow 66 oil 1 hr.
9/15	Bomb test 1470' to drill deeper.
9/22	T.D. 4153 500 acid flow 400 oil per hr through 3/8" choke
9/29	Viola 4146 5" @ 4147 500 acid bomb pot 5950 Max 3000 Gravity 40.9 T.D. 4153'


COMPLETED

Pratt

Section 18 Township 26 Range 11-W

Well No. #2 Stark

Company Geo. Reeves et al

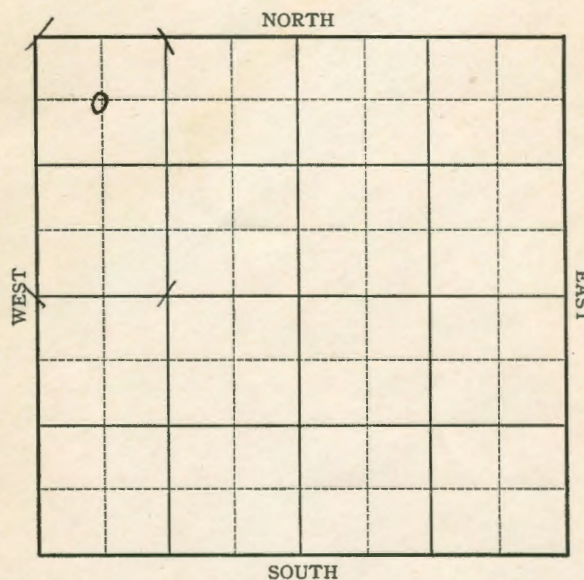

KANSAS

Map No. 47 Sec. 18 Twp. 26 R. 11WWell No. 2 Stark

Geo. Reeves et al. Company

FIRST REPORT Contractor


C NW NW

SECTION PLAT

660 Ft. from N. Line

Ft. from S. Line

Ft. from E. Line

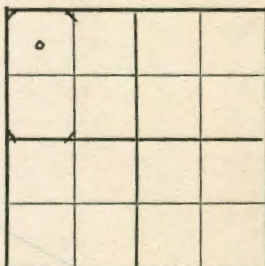660 Ft. from W. Line

STARK POOL

Location XXX

RECORD

Cased _____ in. _____ ft.

Sand _____

Gas _____

Oil _____

Total Depth _____

PRODUCTION

1st 24 hrs. Nat. _____

1st 24 hrs. after shot _____

Gas _____ Cu. Ft.

Dry Hole _____

Abandoned _____

Date

JUL 28 1943

19

S. J. LEWIS Scout

KANSAS

Map No. 47 Sec. 18 Twp. 26 R. 11WWell No. 2 Stark

George Reeves et al. Company

COMPLETED Contractor


C NW NW

SECTION PLAT

660 Ft. from N. Line

Ft. from S. Line

Ft. from E. Line

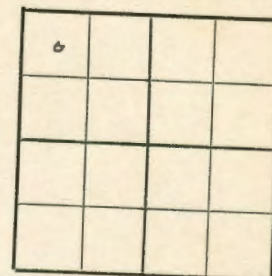660 Ft. from W. Line

Stark Pool

Location XXX

RECORD

Cased _____ in. _____ ft.

Sand _____

Gas _____

Oil _____

Total Depth 4153

PRODUCTION

1st 24 hrs. Nat. _____

1st 24 hrs. after shot _____

Gas _____ Cu. Ft.

Dry Hole _____

Abandoned _____

Date

SEP 29 1943

19

S. J. LEWIS Scout

Viola 4146
5" 20 1/4"
500 gals
Brm & B 45950
Map 3000
40 3/4"