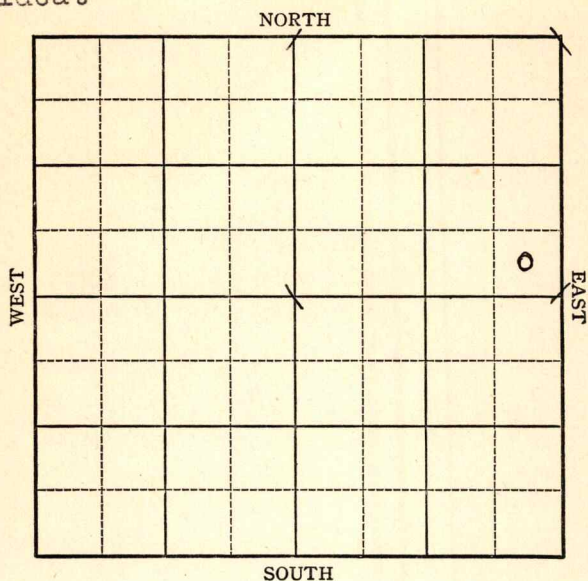


KANSAS

Pratt

Section 22 Township 26 Range 11-WWell No. #1 AllomCompany Barbara Oil & Gas
Wildcat

KANSAS

Pratt

Sec. 22 Twp. 26 R. 11-W

Well No. #1 Allom Farm

Barbara Oil & Gas

Company

Wildcat

Ft. from N. Line

330


Ft. from S. Line

330

Ft. from E. Line

Ft. from W. Line

SE NE

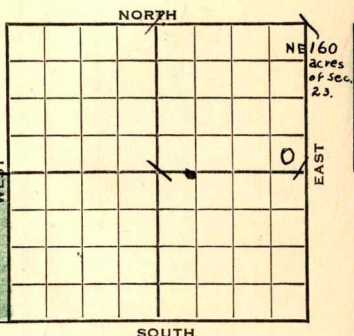

1942

Elev. 1817

REPORT

12/2

Derrick

12/9

8" @ 398'

WOC

12/16

Drlg. 2035'

12/22

Topeka 3070

Drlg. 3535'

12/29

Lans. 3617

Drlg. 2930

1943

1/6

Miss. 4065

SSO 4065-80

Viola 4285

Simp. 4385

Arb. 4457

T.D. 4489 S.D.

1/13

5" casing set 4107'

WOC

1/20

Miss 4065

Arb 4457

5" Casing set 4107'

17 shots 4073-90

10 " 3645-55

13 " 3604-16

HFW

TD 4485'.

ABANDONED

KANSAS

Pratt

Map No. 47 Sec. 22 Twp. 26 R. 11WWell No. 1 Allom


Barbara Oil & Gas

Company

FIRST REPORT

Contractor

SE NE

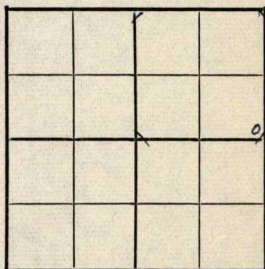SECTION PLAT

_____ Ft. from N. Line

330 Ft. from S. Line330 Ft. from E. Line

_____ Ft. from W. Line

WILDCAT

Location _____

Rig up _____

Drilling and Remarks:

Derrick

RECORD

Cased _____ in., _____ ft.

Sand _____

Gas _____

Oil _____

Total Depth _____

PRODUCTION

1st 24 hrs. Nat. _____

1st 24 hrs. after shot _____

Gas _____ Cu. Ft.

Dry Hole _____

Abandoned _____

Date

DEC 2 1942 19S. J. LEWIS

Scout

KANSAS

Map No. 47 Sec. 22 Twp. 26 R. 11WWell No. 1 Allom

Barbara Oil & Gas


Company

ABANDONED

Contractor

SE NE

SECTION PLAT

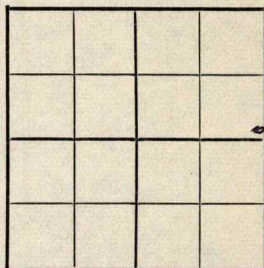

Ft. from N. Line

330

Ft. from S. Line

330

Ft. from E. Line

Ft. from W. Line

WILDCAT

Location

Rig up

Drilling and Remarks:

Mls 4065.

Ar 44457

5" @ 4107

174 hrs to 4073-90

10 " 8645-05

13 " 8604-16

NFW

RECORD

Cased _____ in., _____ ft.

Sand _____

Gas _____

Oil _____

Total Depth 4475

PRODUCTION

1st 24 hrs. Nat. _____

1st 24 hrs. after shot _____

Gas _____ Cu. Ft.

Dry Hole _____

Abandoned _____

Date

JAN 20 1943 19

S. J. LEWIS

Scout