


Section 28 Township 26 Range 11W

Well No. 1 Evers

Company Oil Capitol

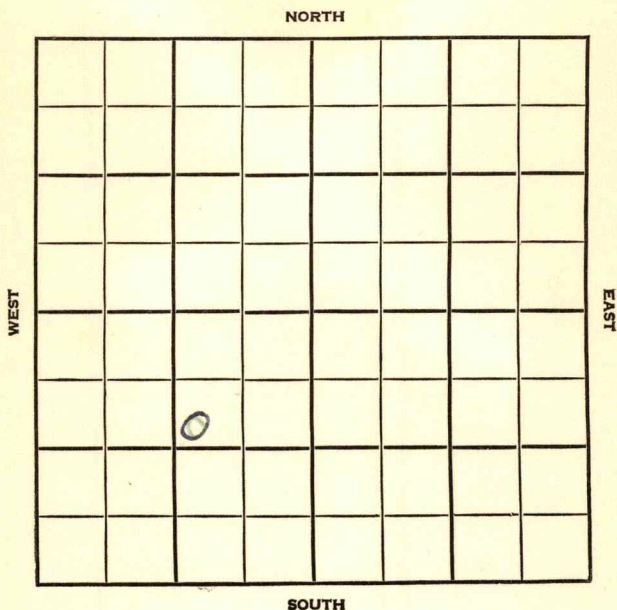

SEC.	TWP.	R.
28	26	11 W

WELL NO.

1 Eyers

FARM

COMPANY

Oil Capitol

CONTRACTOR

Iron Drlg.

Wildcat


_____ Ft. from N. Line

_____ Ft. from S. Line

_____ Ft. from E. Line

_____ Ft. from W. Line

SW NE SW

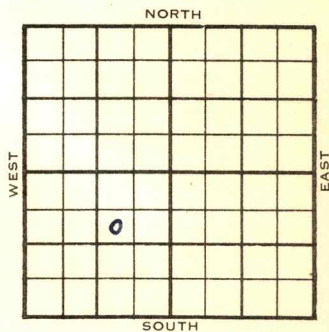

3/4 Mile SD-X Texas FO

	ELEVATION	REPORT
1955	1830'	
7/6	Location	
7/14	Spud 7-755, 8 5/8" @ 232,	Drlg. 2360
7/22	Tops. 3076, Heeb. 3428, Br. Lime 3609, Lans. 3625, Miss. 4079, DST. 3718-46, open 2 1/2 hr. Rec. 240' gas 100' socm, 60' sw, 1120/20"	
7/27	Comm 7-7-55 Tp 3076, H 3428, B1 3609, L 3625, M 4079, K 4144, V 4262, S 4351, S 4361, A 4453, TD 4481 8 5/8" @ 232 DST 3718-46 open 2 1/2 hr. Rec 240' gas 100' socm 60' sw 1120/20" DST 4081-91 open 1 hr Rec 15' drlg mud 0/20" DST 4265-80 open 1 hr gas in 7 min. Rec. 30' ocm 240' muddy oil 700' wtr 710/20" D & A	

ABANDONED

County Pratt Elev. _____
 Sec. 28 Twp. 26 Rge. 11W
 Company Oil Capitol
 Farm Name Eyers No. 1

TOPS	DEPTH	LOG	DATUM
Anh.			
Tp.			
H.			
Tr.			
Dg.			
Bl.			
L.			
K.C.			
B.K.C.			
Ce.			
C.			
M.			
M.			
K.			
Mz.			
Me.			
V.			
S.			
S.			
A.			
R.			
PE.			
G.			
T.D.			

Loc. in Sec. SW NE SW
 Geol. _____
 Contr. Iron Drlg.
 Pool Wildcat
 No. 3/4 mile SW
FIRST REPORT
 JUL 6 '55

Date Comm. Texas FO
 Location _____

26

Co.
Lse.
No.
Sec.
T.
R.

County Pratt Elev. 1830
 Sec. 28 Twp. 26 Rge. 11W
 Company Oil Capitol
 Farm Name Eyers No. 1

TOPS	DEPTH	LOG	DATUM
Anh.			
TP.	3076		1246
H.	3428		1548
Tr.			
Dg.			
BL.	3609		1779
L.	3625		1795
K.C.			
B.K.C.			
Ce.			
C.			
M.	4079		2249
M.			
K.	4144		2314
Mz.			
Me.			
V.	4262		2432
S.	4351		2521
S.	4361		2531
A.	4443		2613
R.			
PE.			
G.			
T.D.	4481		

Loc. in Sec. SW NE SW
 Geol. _____
 Contr. _____
 Iron Drlg.
 Pool
 Wildcat



Date Comm. 7-7-55 **JUL 27 1955**
8 5/8" @ 232 DST 3718-46 open 2 1/2 hr.
Rec. 240' gas 100' socm 60' sw
1120/20" DST 4081-91 open 1 hr.
Rec. 15' drlg. mud 0/20" DST 4265-80
open 1 hr. gas in 7 min. Rec. 30' ocm
240' muddy oil 700' wtr. 710/20"

D & A

Co.
 Lse.
 No.
 Sec.
 T.
 R.