

KANSAS

31

Township

26

Range

11W

#1 Allen

Palmer Oil Company

WEST

EAST

SOUTH

Pratt

KANSAS

Sec. 31 Twp. 26 R. 11WWell No. #1 Allen FarmPalmer Oil Company Company

Contractor


990 Ft. from N. Line

Ft. from S. Line

330 Ft. from E. Line

Ft. from W. Line

SE NE NE

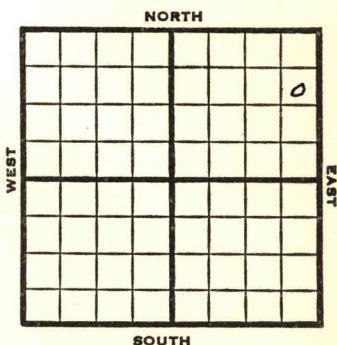

1953

Elev. 1824'

REPORT

3/18

Location

3/26

8" @ 481

Drlg. 2625'

4/2

Br Li 3611, Lans 3626

DST 3659-71

3/4 Hr. 15' M

Drlg 4120'

4/8

Spud 3-17-53

D&A

TD 4500

8" @ 481

Br lime 3611, Lans 3626

DST 3659-71, opn 3/4 hrs., rec. 15' mud

Miss 4080, Viola 4269

DST 4273-4305, opn 1 hr., rec. 120'

gcm, 1200#

Simp 4358, Arb 4449

TD 4500

D&A

ABANDONED

County Prett State Kansas
 Sec. 31 (Blk.) 26 (Sur.) 11W Map No.
 Operator Palmer Oil
 Well No. 1 Farm Allen
 Elev. _____ Location SE NE NE

990 Ft. From N Line NE
330 Ft. From E Line Quarter

1st. Report MAR 1 8 1953

Completion _____

Remarks _____

Spudding Date _____

FIRST REPORT

Drlg. Data _____

Location _____

