


Section 11 Township 26 Range 39 W

Well No. # 1 Zook Gas Unit "D"

Company Stanolind

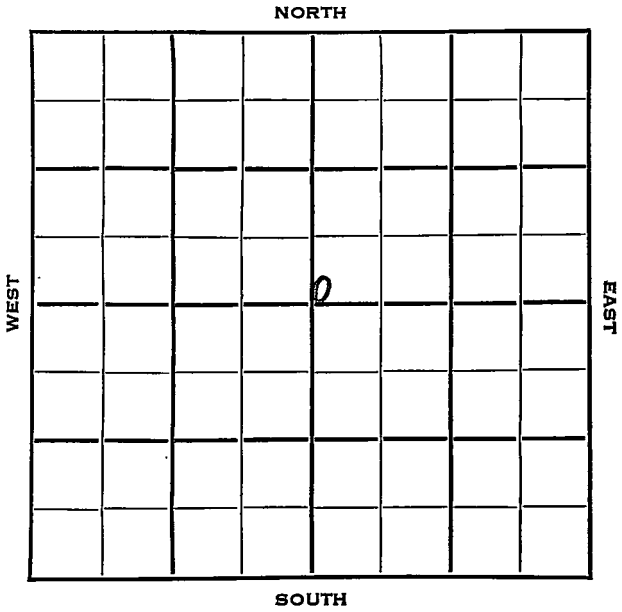

SEC.	TWP.	R.
11	26	39 W ✓

WELL NO.

1 Zook Gas Unit "D"

FARM

COMPANY

Stanolind

CONTRACTOR

Hugoton Pool


_____ Ft. from N. Line

150 _____ Ft. from S. Line

_____ Ft. from E. Line

150 _____ Ft. from W. Line

SW SW NE

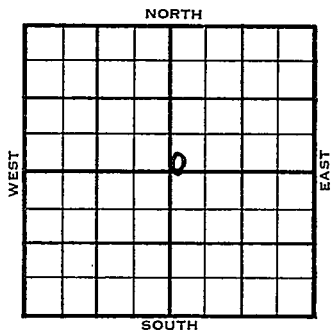

1953

ELEVATION

Elev. 3345'

REPORT

10/14

Spud 10-8-53

8" @ 646

Drlg. 2520'

10/21

RTD 2700'

Schl

5" @ 2684'

Her. Kr. 2516, Win 2566, Up Ft.

2634, Low Ft. 2684,

DD 2709 TD

60/ 2516-26 60/ 2532-42 25/ 2550-

54 84/ 2568-82 30/ 2584-89 34/ 25-

96-2602 24/ 2624-28 18/ 2634-37

30/ 2640-45 42/ 2648-55 24/ 2660-

64 2,402,000 gas 2" tub frac.

hr hr. B.D. 9-3/4 M

10/28

Gas well TD 2709' 8" @ 646

H_r. 2516 Win. 2566 Ft. Riley 2634

TD 2700 5" @ 2684 DD 2709

60/2516-26 60/2532-42 24/2550-54

84/2568-82 30/2584-89 34/2596-2602

24/2624-28 18/2634-37 30/2640-45

42/2648-55 24/2660-64

2,402,000 gas. Frac. 12 hr. BD

9-3/4 MCFG

Comp. 12,236,000 gas. 380#

COMPLETED

