

Section 11 Township 26 Range 35-W

Well No. 10-Building & Loan


Company Helmerich & Payne

Hugoton Pool

NORTH

WEST

EAST

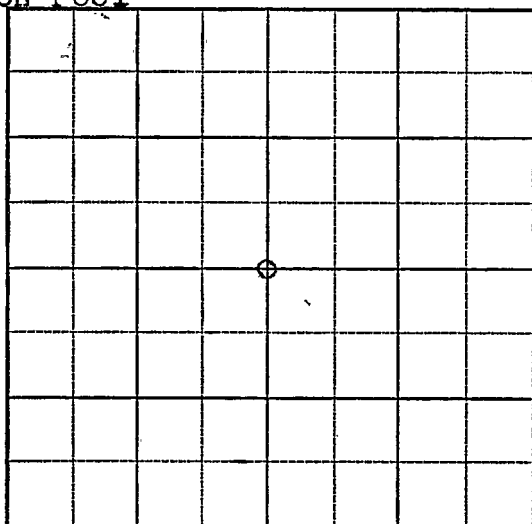

SOUTH

KANSAS

Kearny

Sec. 11 Twp. 26 R. 35W

Well No. #10 Building & Loan Farm

Helmerich & Payne

Company

Hugoton


2640 Ft. from N. Line

Ft. from S. Line

2640 Ft. from E. Line

Ft. from W. Line

C Sec.

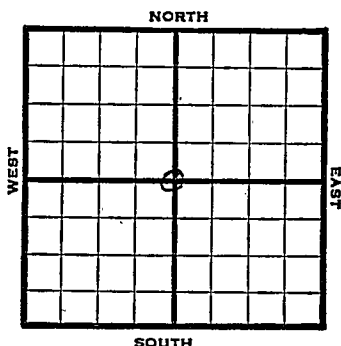

1947

REPORT

9/17 Drlg. 410'

9/24 10" @ 800'
Drlg. 2405'

10/1 7" @ 2528'
TD 2529'

10/8 Drlg. 2540'

10/15 "

10/22 TD 2742-226' of 5" perfliner
@ 2742-3,000 acid

10/29 Acid 12,000

11/5 "

11/12 "

11/19 "

11/25 "

12/3 "

12/10 7" @ 2528'
226' of 5" Perf. Liner @ 2742'
15000 acid, 945,000 gas.
412# R. Pr.
TD 2742'

COMPLETED

Map No. 0 Sec. 11 Twp. 26 R. 35W

Well No. 10 Building & Loan

Helmerich & Payne Company

FIRST REPORT Contractor

C Sec.


SECTION PLAT

2640 Ft. from N. Line

 Ft. from S. Line

2640 Ft. from E. Line ✓

 Ft. from W. Line ✓

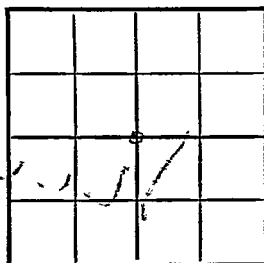

Kearny County

Location

Rig up

Drilling and Remarks:

drlg. 410

RECORD

Cased in., ft.

Sand

Gas

Oil

Total Depth

PRODUCTION

1st 24 hrs. Nat.

1st 24 hrs. after shot

Gas Cu. Ft.

Dry Hole

Abandoned

Date

SEP 17 1947 19

S. J. LEWIS

Scout

Map No. _____ Sec. 11 Twp. 26 R. 35W

Well No. 10 Building & Loan


Helmerich & Payne Company

COMPLETE

Contractor

C Sec.

SECTION PLAT

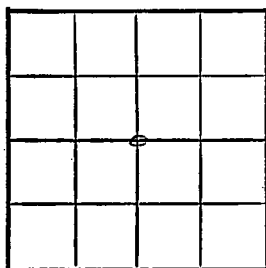

2640 Ft. from N. Line

_____ Ft. from S. Line

2640 Ft. from E. Line

_____ Ft. from W. Line

Kearny County

Location _____

Rig up _____

Drilling and Remarks:

7' 1" C2528
226' 2 1/2" Perf. liner
C2742
150000 cu. ft.
945,000 Gas
4 1/2" R/P

RECORD

Cased _____ in., _____ ft.

Sand _____

Gas _____

Oil _____

Total Depth 2742

PRODUCTION

1st 24 hrs. Nat. _____

1st 24 hrs. after shot _____

Gas _____ Cu. Ft.

Dry Hole _____

Abandoned _____

Date

DEC 10 1947 19

S. J. LEWIS

Scout