

KANSAS


FORM 51 5M PETROL

Pratt

Section 12 Township 26 Range 12-W

Well No. #2 Claycomb

Company Lauck & Moncrief

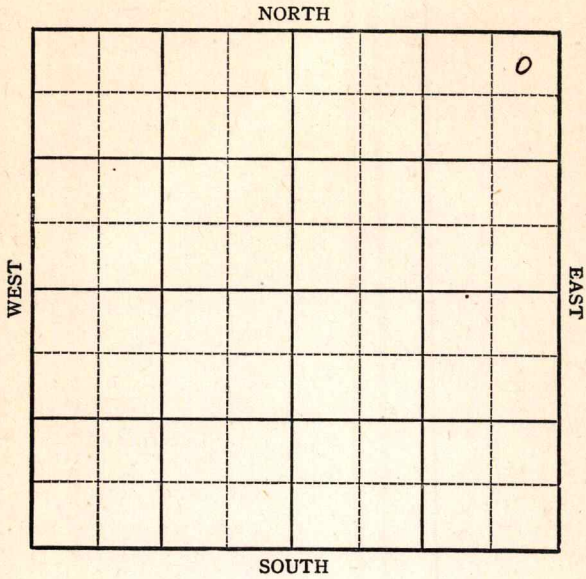

Sec. 12 Twp. 26 R. 12-W

Well No. #2 Claycomb Farm


Lauck & Moncrief Company

330 Ft. from N. Line

_____ Ft. from S. Line

330 Ft. from E. Line

_____ Ft. from W. Line

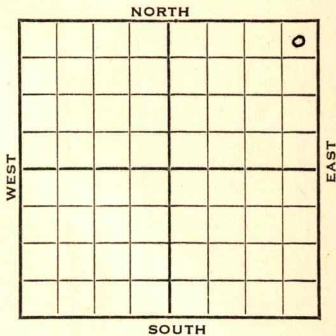

1943

elec. 1860 REPORT

8/25

Location

9/1

"

9/8

"

9/15

10" @ 280'
Drlg. 2198'

9/22

Drlg. 3470'

9/29

Viola 4119-30 T.D.
5" @ 4128'
Rust

10/6

Drlg. 4255'

10/13

Drlg. 4305'

10/20

Arb 4311
Water
T.D. 4322'

ABANDONED

KANSAS

Map No. 47 Sec. 12 Twp. 26 R. 12W

Well No. 2 Claycomb

Lauck & Moncrief Company

FIRST REPORT

Contractor

NE/C

SECTION PLAT

330 Ft. from N. Line

_____ Ft. from S. Line

330 Ft. from E. Line

_____ Ft. from W. Line

StarkNorth Pool

			o

Location X

Rig up _____

Drilling and Remarks:

RECORD

Cased _____ in., _____ ft.

Sand _____

Gas _____

Oil _____

Total Depth _____

PRODUCTION

1st 24 hrs. Nat. _____

1st 24 hrs. after shot _____

Gas _____ Cu. Ft.

Dry Hole _____

Abandoned _____

Date

AUG 25 1943 19

S. J. LEWIS Scout

KANSAS

Map No. 47 Sec. 12 Twp. 26 R. 12W

Well No. 2 Claycomb

Leuck & Moncrief Company

ABANDONED Contractor

NE/C

SECTION PLAT

			0

330 Ft. from N. Line

_____ Ft. from S. Line

330 Ft. from E. Line

_____ Ft. from W. Line

Sterkworth Pool

Location _____

Rig up _____

Drilling and Remarks:

*Cor 4311
Water*

RECORD

Cased _____ in., _____ ft.

Sand _____

Gas _____

Oil _____

Total Depth 4922

PRODUCTION

1st 24 hrs. Nat. _____

1st 24 hrs. after shot _____

Gas _____ Cu. Ft.

Dry Hole _____

Abandoned _____

Date

OCT 20 1943

19

S. J. LEWIS

Scout