


Section 4 Township 26 Range 12-W

Well No. #1 *L. Hays* ~~J. L. Phelps~~

Company Colonial Oil et al

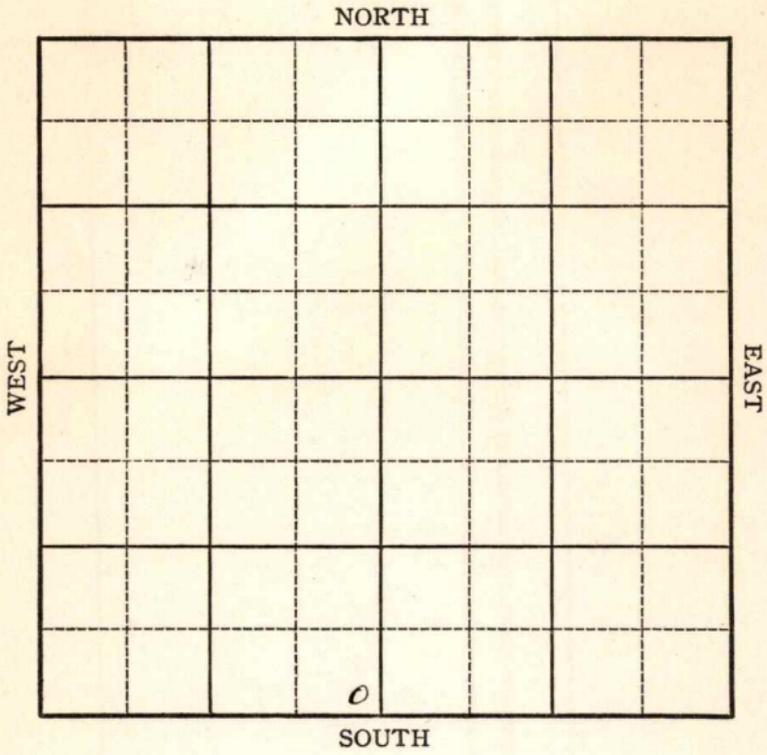

Map No. _____ Sec. 4 Twp. 26 R. 12W

Well No. 1- J L Phelps

Colonial Oil etal Company

Contractor _____

Contractor _____

FIRST REPORT

SE SW

SECTION PLAT

_____ Ft. from N. Line

330 Ft. from S. Line

330 Ft. from E. Line

_____ Ft. from W. Line

Drill site East 53 Acres of SW

Location XX

Rig up _____

Drilling and Remarks:

(Stano. Farm out)

RECORD

Cased _____ in., _____ ft

Sand _____

Gas _____

Oil _____

Total Depth _____

PRODUCTION

1st 24 hrs. Nat. _____

1st 24 hrs. after shot _____

Gas _____ Cu. Ft.

Dry Hole _____

Abandoned _____

Date

SEP 29 1931 19

H. D. Hatfield

Scout

Pratt **KANSAS**

Map No. 47 Sec. 4 Twp. 26 R. 12^W

Well No. 1-L. Hays

Colonial Oil etal Company

CORRECTION

Contractor

SECTION PLAT

se sw

_____ Ft. from N. Line

330 Ft. from S. Line

330 Ft. from E. Line

_____ Ft. from W. Line

CORRECTION

Location _____

Rig up _____

Drilling and Remarks:

farm name first reported as being J. L. Phelps

RECORD

Cased _____ in., _____ ft.

Sand _____

Gas _____

Oil _____

Total Depth _____

PRODUCTION

1st 24 hrs. Nat. _____

1st 24 hrs. after shot _____

Gas _____ Cu. Ft.

Dry Hole _____

Abandoned _____

Date

OCT 13 1937

19

H. D. Hatfield

Scout

Pratt

KANSAS

Map No. 47 Sec. 4 Twp. 26 R. 12W

Well No. 1 L.Hays

Colonial Oil etal Company

Contractor

ABANDONED

SE SW

 Ft. from N. Line

330 Ft. from S. Line

330 Ft. from E. Line

 Ft. from W. Line

SECTION PLAT

0

Location

Rig up

Drilling and Remarks:

*Sulphur odor
in core.*

DVA

RECORD

Cased in., ft.

Sand sil 4300

Gas

Oil

Total Depth 4325

PRODUCTION

1st 24 hrs. Nat.

1st 24 hrs. after shot

Gas Cu. Ft.

Dry Hole

Abandoned

Date

NOV 17 1937 19

H. D. Hatfield Scout