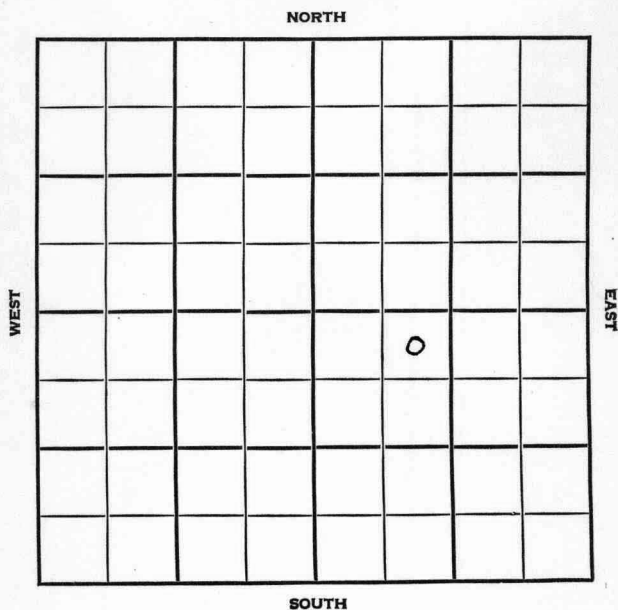


Pratt County, Kansas

Section 4 Township 26S Range 12WWell No. #1 SnyderCompany Coppinger

Pratt

KANSAS

SEC.	TWP.	R.
4	26	12W

WELL NO.

#1 Snyder

FARM

COMPANY

Coppinger

CONTRACTOR

Co. Tools


Wildcat

_____ Ft. from N. Line

_____ Ft. from S. Line

_____ Ft. from E. Line

_____ Ft. from W. Line

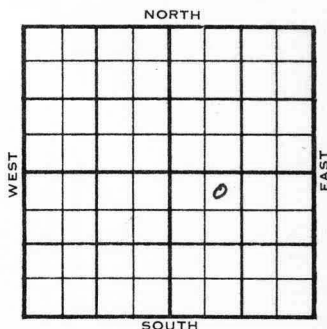

NE NW SE

Atl AC & DHM

1955	ELEVATION	REPORT
	1878'	
8/31	Comm 8-28-55 8" @ 326/175 Anh 660 Drlg 1475	
9-21	DST 3787-3817 open 1 hr., rec. 5' mud BHP 63# 15" DST 4101-10 op 90" rec. 25' mud BHP 32# 15" D & A	
	<u>Tops</u>	<u>Depth</u>
	H.	3436
	Tr.	3453
	Dg.	3469
	B.L.	3612
	L.	3635
	B.K.C.	3950
	Marm	3966
	M.	4049
	V.	4100
	S.	4180
	A	4288
	T.D. 4307'	

ABANDONED

County

Pratt

Elev.

Sec.

4

Twp.

26

Rge.

12W

Company

Coppinger

Farm Name

Snyder

No.

1

TOPS

DEPTH

LOG

DATUM

Anh.

660

Tp.

H.

Tr.

Dg.

B.L.

L.

K.C.

B.K.C.

Ce.

C.

M.

M.

K.

Mz.

Me.

V.

S.

S.

A.

R.

Pe.

G.

G.

I.D.

Loc. in Sec.

NE NW SE

Geol.

Contr.

Co. tools

Pool

Wildecut



Date Comm.

8-28-55

Atl. AC & DHM

8" @ 326/175 drlg. 1475

28

County Pratt Elev. 1878
 Sec. 4 Twp. 26 Rge. 12W
 Company Coppinger
 Farm Name Snyder No. 1

TOPS	DEPTH	LOG	DATUM
Anh.	660		
Tr.			
H.	3436	3434	1556
Tr.	3453		1575
Dg.	3469		
BL.	3612	3610	1732
L.	3635	3633	1755
K.C.			
B.K.C.	3950		2072
Ce. <u>Marm</u>	3966		2088
C.			
M.	4049	4044	2166
M.			
K.			
Mz.			
Mq.			
V.	4100	4114	2236
S.	4180	4196	2318
S.			
A	4288	4288	2410
R.			
PE.			
G.			
T.D.	4307		

Loc. in Sec. _____

NE NW SE

Geol. _____

Contr. _____

Pool _____

W.C. _____

ABANDONED

SEP 21 1955

Date Comm. 8/28/55 At1. AC & DHM

8" 326 w/175 DST 3787-3817 open 1 hr.

Rec. 5' mud BHP 63# 15" DST 4101-10 open

90" Rec. 25' mud BHP 32# 15"

D & A