KANSAS


FORM 51 5M 1-42 PETROL

Pratt

Section 12 Township 26 Range 12-W

Well No. #1 Ford

Company Lion Oil & Refining

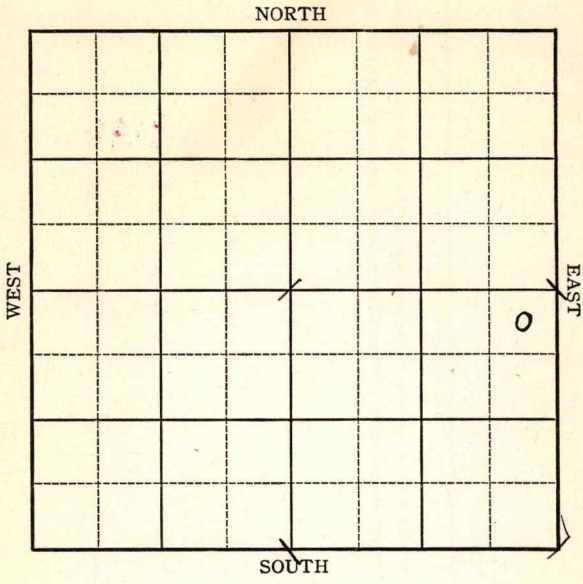

FORM 252-A
5M 9-42 GASS

KANSAS Pratt

Sec. 12 Twp. 26 R. 12-W

Well No. #1 Ford Farm

Lion Oil & Refining Company

Wildcat


330 Ft. from N. Line

Ft. from S. Line

330 Ft. from E. Line

Ft. from W. Line

Elev. 1860

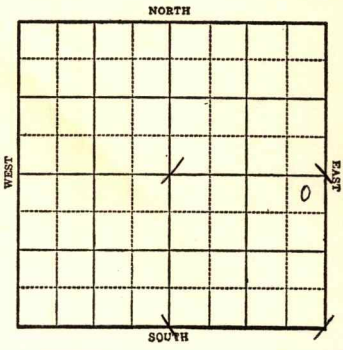

1943	REPORT
3/10	Derrick
3/17	8" Casing set 292 Drlg. 2250'
3/24	Topeka 3116 Douglas Sd. 3442 Lans 3622 Drlg. 3652'
3/31	Lans 3117 SO Miss 3956 Kind 4013 Viola 4135 TD 4144 5" @ 4137 Rust
4/14	Viola 4135 5" @ 4137' T.D. 4145' Bomb. Pot. 1031' Gravity 40

COMPLETED

Form 26 200 Bks 5-42 Petrol

Pratt

KANSAS

Map No. 47 Sec. 12 Twp. 26 R. 12W

Well No. 1 Ford

Lion Oil & Refining Company

COMPLETED Contractor

NE SE


330 Ft. from N. Line

Ft. from S. Line

330 Ft. from E. Line

Ft. from W. Line

SECTION PLAT

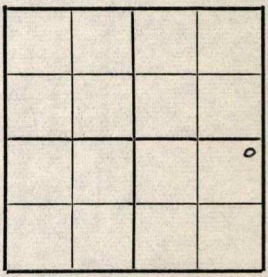

WILDCAT

Location

Rig up

Drilling and Remarks:

Viola 4135.

5½ @ 4137

Bomb PBTD 1091.

40 & 5A

RECORD

Cased in., ft.

Sand

Gas

Oil

Total Depth 4145.

PRODUCTION

1st 24 hrs. Nat.

1st 24 hrs. after shot

Gas Cu. Ft.

Dry Hole

Abandoned

Date

APR 14 1943 19

S. J. LEWIS Scout

Form 26 200 Bks 5-42 Petrol

Pratt

KANSAS

Map No. 77 Sec. 12 Twp. 26 R. 12W

Well No. 1 Ford

Lion Oil & Refining Company

FIRST REPORT Contractor

NE SE

330 Ft. from N. Line


_____ Ft. from S. Line

330 Ft. from E. Line

_____ Ft. from W. Line

WILDCAT

SECTION PLAT

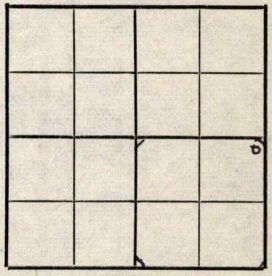

Location _____

Rig up _____

Drilling and Remarks:

Derrick

RECORD

Cased _____ in., _____ ft.

Sand _____

Gas _____

Oil _____

Total Depth _____

PRODUCTION

1st 24 hrs. Nat. _____

1st 24 hrs. after shot _____

Gas _____ Cu. Ft.

Dry Hole _____

Abandoned _____

Date

MAR 10 1943 19

S. J. LEWIS Scout