

KANSAS


FORM 51 5M 1-42 PETROL

Pratt

Section 12 Township 26 Range 12-W

Well No. #3 Ford

Company Lion Oil Refining

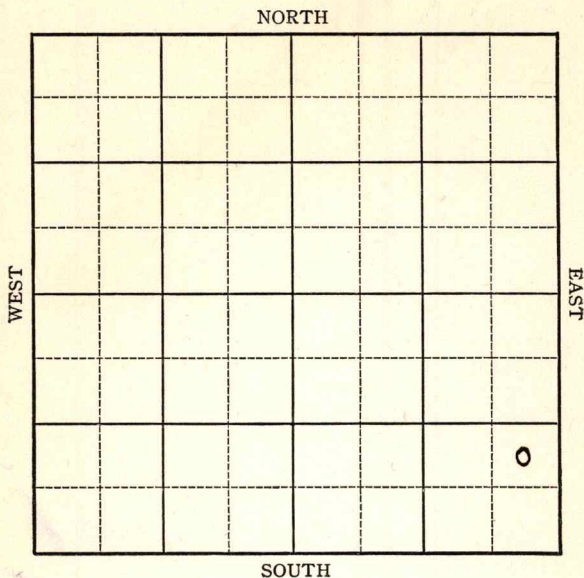

KANSAS

Pratt

Sec. 12 Twp. 26 R. 12-W

Well No. #3 Ford Farm

Lion Oil Refining Company


 Ft. from N. Line

990 Ft. from S. Line

330 Ft. from E. Line

 Ft. from W. Line

Stark North Pool

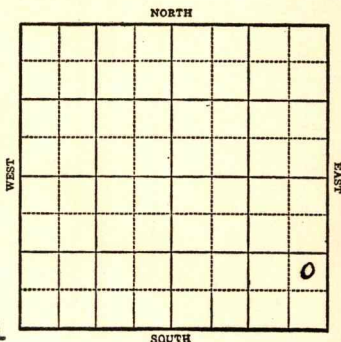

1943

Elev. 1861

R E P O R T

7/28

Location

8/4

Rotary

8/11

8" @ 301'

Drlg. 2200'

8/18

rlg. 3725'

8/25

Lans 3632

Viola 4144

T.D. 4148

5" @ 4146 $\frac{1}{2}$

Rust

9/1

Viola 4144

5" @ 4146 $\frac{1}{2}$

500 acid

Bomb Pot. 43,975

Max 3000

T.D. 4148

Grav. 40.9

COMPLETED

KANSAS

Pratt

Map No. 17 Sec. 12 Twp. 26 R. 12WWell No. 3 FordLion Oil Refining Company

FIRST REPORT

Contractor

NE SE SE

SECTION PLAT

			0

Ft. from N. Line

990 Ft. from S. Line330 Ft. from E. Line

Ft. from W. Line

STARK NORTH POOL

Location XXXX

Rig up

Drilling and Remarks:

RECORD

Cased _____ in., _____ ft.

Sand _____

Gas _____

Oil _____

Total Depth _____

PRODUCTION

1st 24 hrs. Nat. _____

1st 24 hrs. after shot _____

Gas _____ Cu. Ft.

Dry Hole _____

Abandoned _____


Date

JUL 28 1943 19S. J. LEWIS Scout

KANSASMap No. 47 Sec. 12 Twp. 26 R. 12WWell No. 3 FordLion Oil Refining Company**COMPLETED**

Contractor

NE SE SE

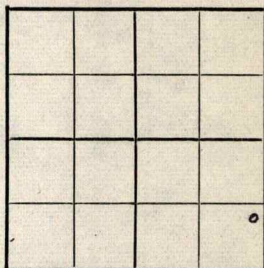SECTION PLAT Ft. from N. Line990 Ft. from S. Line330 Ft. from E. Line Ft. from W. Line**Stark North Pool**Location Rig up

Drilling and Remarks:

*Viola 4144**5" @ 4146 1/2**500 gals**Born & Pot 43975**Max 3000**40 1/2 gals***RECORD**Cased in., ft.Sand Gas Oil Total Depth 4148**PRODUCTION**1st 24 hrs. Nat. 1st 24 hrs. after shot Gas Cu. Ft.Dry Hole Abandoned

Date

SEP 1 1943

19

S. J. LEWIS

Scout