

KANSAS


Pratt

FORM 51 5M PETROL

Section 12 Township 26 Range 12W

Well No. 5 Ford

Company Lion Oil

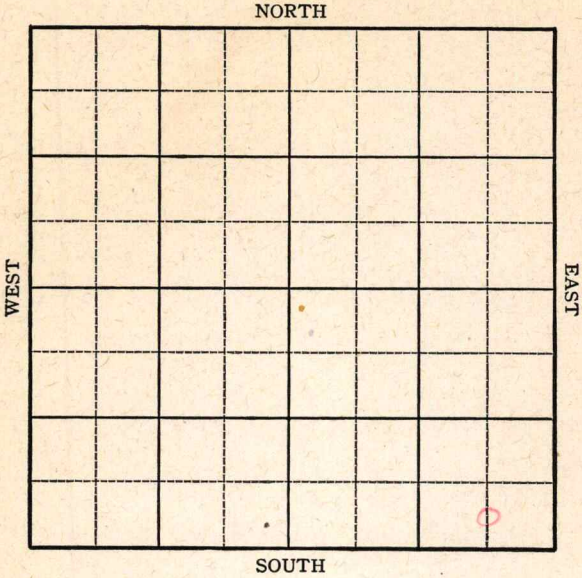

Sec. 12 Twp. 26 R. 12-W

Well No. #5 Ford Farm


Lion Oil Company

 Ft. from N. Line

330 Ft. from S. Line

660 Ft. from E. Line

 Ft. from W. Line

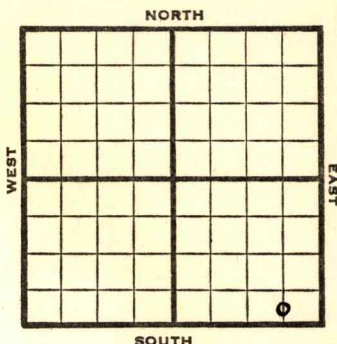

C S L SE SE

1945 **Elev. 1869** REPORT

9/19 RUR

9/26 Drlg. 1770

10/3 9" @ 287

Drlg. 2715

10/10 Drlg. 3615

10/17 Miss. 3992

Viola 4157-4159

TD 4159

5" @ 4158' RUST

10/24 " " "

10/31 TD 4162

Flow 65 oil in 12 hrs.

11/7 " " " "

11/14 " " " "

11/21 " " " "

11/28 " " " "

12/5 Viola 4157

5" @ 4158

TD 4162

Pump 85 Pot.

Grav. 40.9

COMPLETED

KANSAS
Kansas

Pool Name Stark

Map No. 47 Sec. 12 Twp. 26 R. 12W

Well No. 5 Ford

Lion Oil Company

FIRST REPORT

Contractor

C S L SE SE

SECTION PLAT

 Ft. from N. Line

330 Ft. from S. Line

660 Ft. from E. Line

 Ft. from W. Line

| | | | |
|--|--|--|--|
| | | | |
| | | | |
| | | | |
| | | | |

Pratt County

Location

Rig up

Drilling and Remarks:

RUR

RECORD

Cased in., ft.

Sand

Gas

Oil

Total Depth

PRODUCTION

1st 24 hrs. Nat.

1st 24 hrs. after shot

Gas Cu. Ft.

Dry Hole

Abandoned

Date

SEP 1 9 1945 19

S. J. LEWIS Scout

KANSAS

Kansas Pool Name Stark

Map No. K-47 Sec. 12 Twp. 26 R. 12W

Well No. 5 Ford

Lion Oil Company

COMPLETED

Contractor

C S L SE SE

E. 1/8 69

SECTION PLAT

| | | | |
|--|--|--|--|
| | | | |
| | | | |
| | | | |
| | | | |

Ft. from N. Line

330 Ft. from S. Line

660 Ft. from E. Line

Ft. from W. Line

Pratt County

Location _____

Rig up _____

Drilling and Remarks:

Viola 4157
5" 4158
Pump 5000

40 9/22

RECORD

Cased _____ in., _____ ft.

Sand _____

Gas _____

Oil _____

Total Depth 4162

PRODUCTION

1st 24 hrs. Nat. _____

1st 24 hrs. after shot _____

Gas _____ Cu. Ft.

Dry Hole _____

Abandoned _____

Date

DEC 5 1945 19

S. J. LEWIS Scout