Form 51-5M 5-37 Petrol


Pratt

KANSAS

Section 13 Township 26 Range 12-W

Well No. 1 Delaney

Company Cities Service Oil & Atlantic

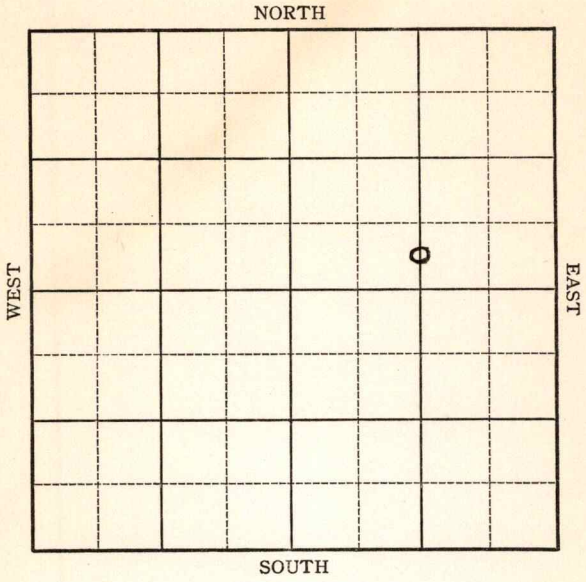


Form 252-A—5M—9-37 KANSAS Pratt

Sec. 13 Twp. 26 R. 12-W

Well No. #1 Delaney Farm

Cities Service & Atlantic Company

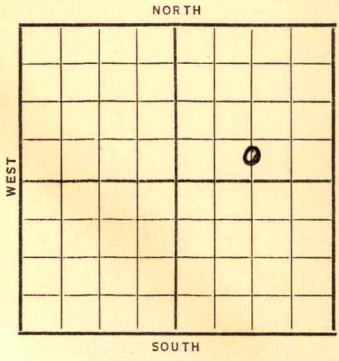

_____ Ft. from N. Line

440 Ft. from S. Line

1320 Ft. from E. Line

_____ Ft. from W. Line

Elev. 1866'.

Date	REPORT
1938	
1/26	Location
2/4	" "
2/11	S. H.
2/18	12" @ 346'. Drlg. 1981'.
2/26	Drlg. 2820'.
3/4	Anhy 675'. Topeka 3105'.
	Lans. 3613'. S.S.O. 3653-58'.
	T.D. 3740'. Circ.
3/11	Oil stains 3790-3800; 3820-29 &
	3850'. Erosional Cong. 3983'.
	Drlg. 4070'.
3/16	Viola 4139'.
	Simp. 4245'.
	Arb. 4316'.
	T.D. 4347'.
	ABANDONED

Form 26—1M Bks.—2-29 Pratt KANSAS

Map No. 47 Sec. 13 Twp. 26 R. 12W

Well No. 1 Delaney

Cities Service Oil & Atlantic Company

Contractor

ABANDONED

C S L NE


_____ Ft. from N. Line

440 Ft. from S. Line

1320 Ft. from E. Line

_____ Ft. from W. Line

SECTION PLAT

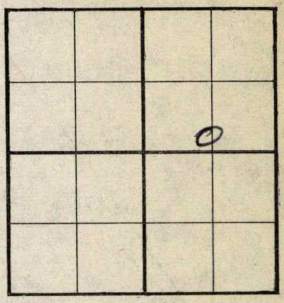

Location _____

Rig up _____

Drilling and Remarks:

Viola 4139

Simp 4245

Arb 4316

TD 4347

D & A

RECORD

Cased _____ in., _____ ft.

Sand _____

Gas _____

Oil _____

Total Depth _____

PRODUCTION

1st 24 hrs. Nat. _____

1st 24 hrs. after shot _____

Gas _____ Cu. Ft.

Dry Hole _____

Abandoned _____

Date

MAR 16 1938 19 _____

H. D. Hatfield Scout

Form 26—1M Bks.—2-29 Pratt KANSAS

Map No. 47 Sec. 13 Twp. 26 R. 12W

Well No. 1 Delaney

Cities Service Oil & Atlantic Company

Contractor

FIRST REPORT

C S L NE


Ft. from N. Line

440 Ft. from S. Line

1320 Ft. from E. Line

Ft. from W. Line

SECTION PLAT

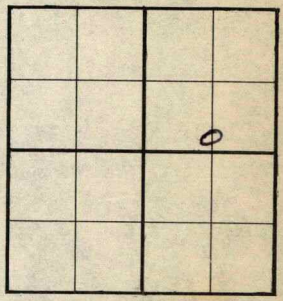

Location X

Rig up

Drilling and Remarks:

RECORD

Cased in., ft.

Sand

Gas

Oil

Total Depth

PRODUCTION

1st 24 hrs. Nat.

1st 24 hrs. after shot

Gas Cu. Ft.

Dry Hole

Abandoned

Date

JAN 26 1938 19

H. D. Hatfield Scout