


Section 13 Township 26 Range 12W

Well No. #3, Haley

Company George Reeves et al

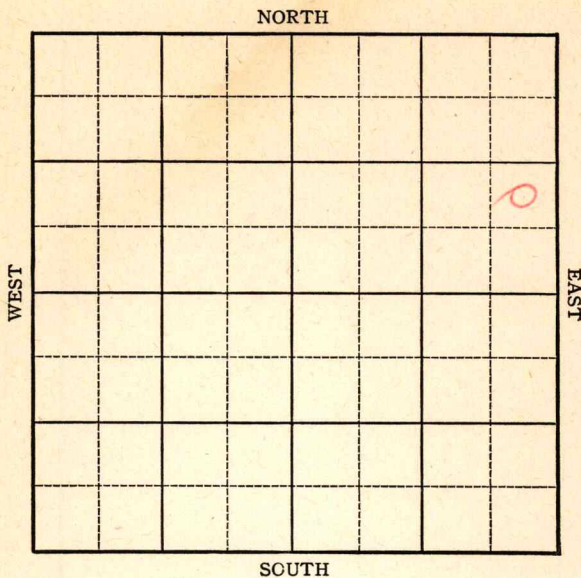

KANSAS

Pratt County

Sec. 13 Twp. 26 R. 12W

Well No. #3 Haley Farm _____

Geo. Reeves et al Company _____

Stark


_____ Ft. from N. Line

990 Ft. from S. Line

330 Ft. from E. Line

_____ Ft. from W. Line

NE SE NE

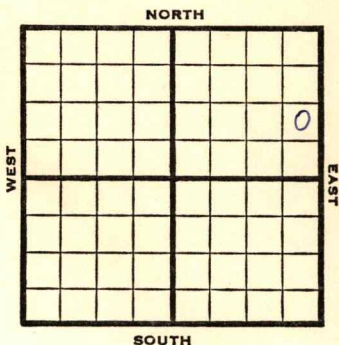

1946

Elev. 1867

REPORT

4/10 RUR

4/16 8" @ 330
Drlg 2630

4/23 TD 4145-5" @ 444ORUST

5/1 **Lans 3610**
Miss 3980
Viola 4146-60 TD
Swb 1½ fluid PH 25% w.

5/8 **Viola 4143**
5" @ 4140
TD 4160
Pump 158 oil plus 32% wtr. Pot.
Grav. 39.0

COMPLETED

