KANSAS


Pratt

FORM 51 5M 1-42 PETROL

Section 13 Township 26 Range 12-W

Well No. Haley #1 ~~M. Delaney~~

Company Margay Oil Corp.

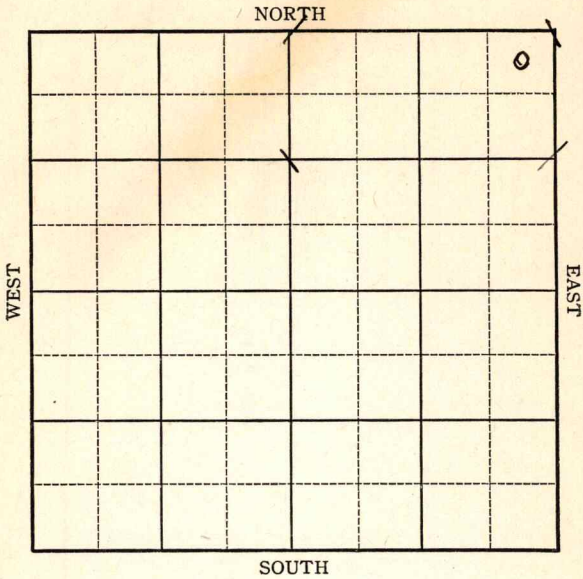

FORM 252-A
5M 9-42 GASS

KANSAS

Pratt

Sec. 13 Twp. 26 R. 12-W

Well No. #1 ~~W. Delaney~~ Haley Farm

Margay Oil Corp. Company


330 Ft. from N. Line

Ft. from S. Line

330 Ft. from E. Line

Ft. from W. Line

Stark Pool North

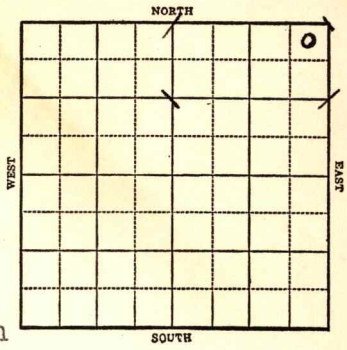

1943	REPORT
7/28	Surface Hole
8/4	10" @ 300' Drlg. 2000'
8/11	Drlg. 3230'
8/18	Drlg. 3666' Lans 3610'
8/25	Viola 4154 SO 4155 T.D. 5" @ 4154 Rust
9/1	T.D. 4160 H.F.O.
9/8	Flow 50 oil 1 Hr.
9/15	Viola 4154 5" @ 4154 500 acid Bomb Pot. 6227 Max. 3000 T.D. 4160 Gravity 40.9

COMPLETED

Form 26 200 Bks 5-42 Petrol

KANSAS

Pratt

Map No. 17 Sec. 13 Twp. 26 R. 12W

Well No. 1 M. Delaney

Margay Oil Corp. Company

FIRST REPORT Contractor

NE/C


330 Ft. from N. Line

Ft. from S. Line

330 Ft. from E. Line

Ft. from W. Line

SECTION PLAT

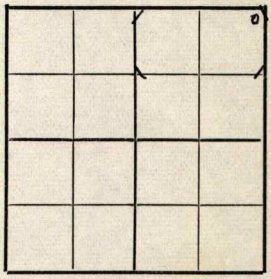

STARK POOL NORTH

Location

Rig up

Drilling and Remarks:

Surface Hole

RECORD

Cased in., ft.

Sand

Gas

Oil

Total Depth

PRODUCTION

1st 24 hrs. Nat.

1st 24 hrs. after shot

Gas Cu. Ft.

Dry Hole

Abandoned

Date

JUL 2 8 1943 19

S. J. LEWIS Scout

Form 26 200 Bks 5-42 Petrol

Pratt

KANSAS

Map No. 47 Sec. 13 Twp. 26 R. 12W

Well No. 1 M. Delaney

Margay Oil Corp. Company

COMPLETED Contractor

NE/C


330 Ft. from N. Line

Ft. from S. Line

330 Ft. from E. Line

Ft. from W. Line

SECTION PLAT

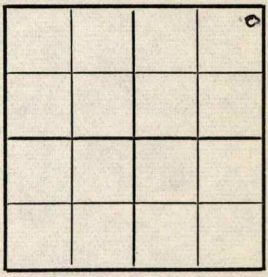

Stark North Pool

Location

Rig up

Drilling and Remarks:

Viola 4154

5" @ 4154

5 00 acid

Bom Ls 4 6227

Map 3000

40-9 Gr

RECORD

Cased in., ft.

Sand

Gas

Oil

Total Depth 4160

PRODUCTION

1st 24 hrs. Nat.

1st 24 hrs. after shot

Gas Cu. Ft.

Dry Hole

Abandoned

Date

SEP 15 1943 19

S. J. LEWIS Scout

Form 26 200 Blks 5-42 Petrol Pratt.

KANSAS

Map No. 47 Sec. 13 Twp. 26 R. 12W

Well No. 1 Haley

Margay Oil Company

CORRECTION Contractor

NE/C

330 Ft. from N. Line


Ft. from S. Line

330 Ft. from E. Line

Ft. from W. Line

Stark Pool

SECTION PLAT

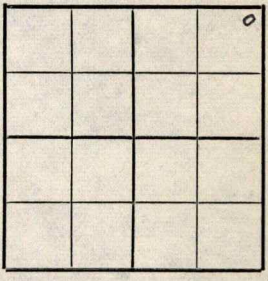

Location

Rig up

Drilling and Remarks:

Farm name changed. Completed Sept. 15/43

RECORD

Cased in., ft.

Sand

Gas

Oil

Total Depth

PRODUCTION

1st 24 hrs. Nat.

1st 24 hrs. after shot

Gas Cu. Ft.

Dry Hole

Abandoned

Date

SEP 2 9 1943 19 S. J. LEWIS Scout