KANSAS


FORM 51 5M PETROL

Pratt

Section 13 Township 26 Range 12W

Well No. #1 Haynes

Company Transwestern

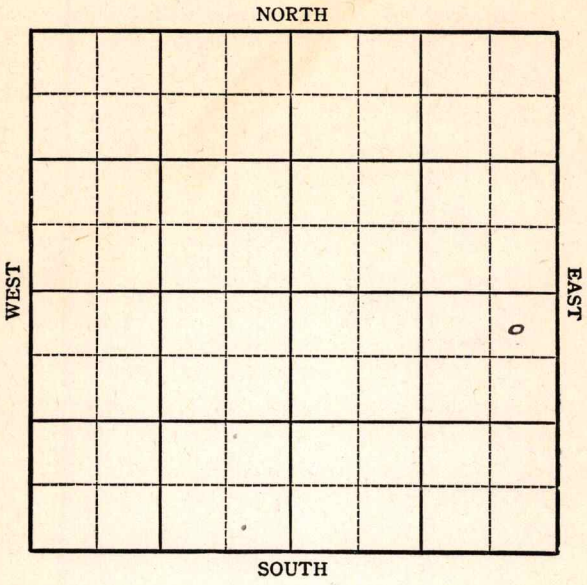

FORM 252-A
5M 9-43 GASS

KANSAS

Pratt

Sec. 13 Twp. 26 R. 12W

Well No. #1 Haynes Farm

Transwestern Company


Stark

360 ~~330~~ Ft. from N. Line

Ft. from S. Line

475 ~~450~~ Ft. from E. Line

Ft. from W. Line

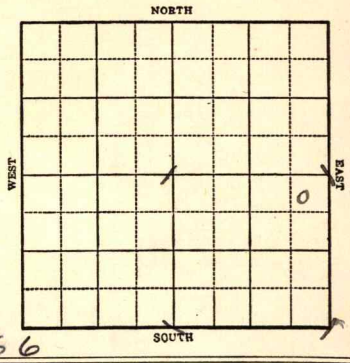

NE SE Elev. 1866

1944	REPORT
2/9	Location
2/15	Rotary
2/23	Surface hole
3/1	9" @ 341 Drlg. 2575'
3/8	Drlg. 3833
3/16	Lans 3590 Viola 4122 S O & G 4144-48 TD 4151 5" @ 4149 Rust
3/22	11 shots 4143-46½-500 acid.
3/29	TD 4156 PB 3149
4/5	TD 4156 1000 acid 15 M gas.
4/12	" " " "
4/19	" " "
4/26	" " "

OVER

1944

5/3 TD 3156' acid 15 M. gas

5/10 " "

5/17 " "

5/24 " "

5/31 " "

6/7 " "

6/15 " "

6/21 " "

6/28 " " " " "

7/12 " " " " "

7/19 " " " " "

7/26 " " " " " "

8/2 " " " " " "

8/9 " " " " " "

8/16 " " " " " "

8/23 " " " " " "

8/30 " " " " " "

9/8 " " " " " "

9/13 " " " " "

9/20 Viola 4122
5" @ 4149
1000 acid
TD 4156
15 M Gas

COMPLETED

Form 26 200 Bks 5-42 Petrol

Pratt

KANSAS

Map No. 47 Sec. 13 Twp. 26 R. 12W


Well No. 1 Haynes

Transwestern Company

FIRST REPORT Contractor

NE SE

SECTION PLAT

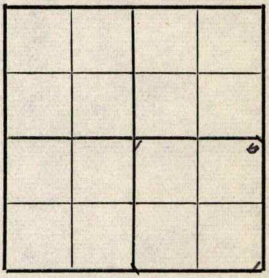

330 Ft. from N. Line

____ Ft. from S. Line

450 Ft. from E. Line

____ Ft. from W. Line

Stark Pool

Location x

Rig up

Drilling and Remarks:

RECORD

Cased ____ in., ____ ft.

Sand

Gas

Oil

Total Depth

PRODUCTION

1st 24 hrs. Nat.

1st 24 hrs. after shot

Gas ____ Cu. Ft.

Dry Hole

Abandoned

Date

FEB 9 1944 19 S. J. LEWIS Scout

Form 26 200 Bks 5-42 Petrol **Pratt**

KANSAS

Map No. 7 Sec. 13 Twp. 26 R. 12W

Well No. 1 Haynes

Transwestern Company

CORRECTION Contractor

NE SE


363 Ft. from N. Line

_____ Ft. from S. Line

475 Ft. from E. Line

_____ Ft. from W. Line

SECTION PLAT

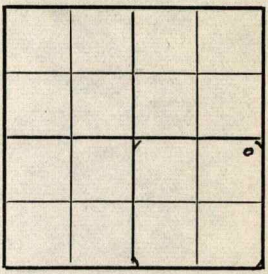

Stark Pool

Location _____

Rig up _____

Drilling and Remarks:

Reported
330 x 450

RECORD

Cased _____ in., _____ ft.

Sand _____

Gas _____

Oil _____

Total Depth _____

PRODUCTION

1st 24 hrs. Nat. _____

1st 24 hrs. after shot _____

Gas _____ Cu. Ft.

Dry Hole _____

Abandoned _____

Date

FEB 16 1944 19____ S. J. LEWIS Scout

FORM 26 200 BKS 1-44 PETROL

KANSAS

Pool Name Stark Pool

Map No. 47 Sec. 13 Twp. 26 R. 12W

Well No. 1 Haynes

Transwestern Company

COMPLETED

Contractor

NE SE


363 Ft. from N. Line

Ft. from S. Line

475 Ft. from E. Line

Ft. from W. Line

SECTION PLAT

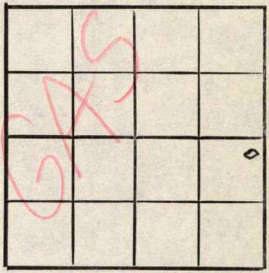

Pratt County

Location

Rig up

Drilling and Remarks:

Viola 4122

5" C 4149

1000 acid

15 M Gas

RECORD

Cased in., ft.

Sand

Gas

Oil

Total Depth 4156

PRODUCTION

1st 24 hrs. Nat.

1st 24 hrs. after shot

Gas Cu. Ft.

Dry Hole

Abandoned

Date

SEP 2 0 1944 19 S. J. LEWIS Scout