


Section 32 Township 26 Range 12-W

Well No. #4 Miskiman

Company Tidewater

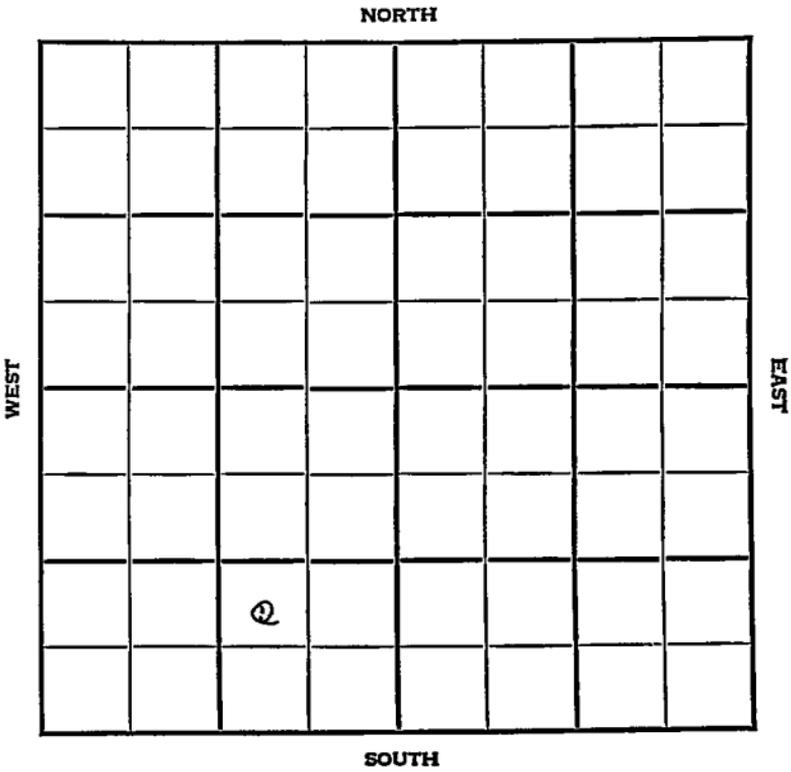



Sec. 32 Twp. 26 R. 12W

Well No. #4 Miskiman Farm
Tidewater Company

Carmi Pool


_____ Ft. from N. Line

990' _____ Ft. from S. Line

990' _____ Ft. from E. Line

_____ Ft. from W. Line

NW SE SW

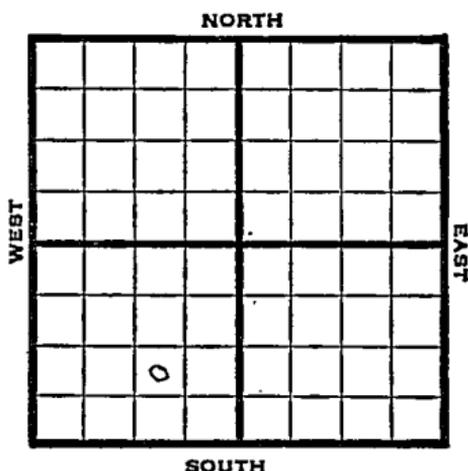

1948 Eli 1908' REPORT

- 6/16 Drlg. 540'
- 6/23 8" @ 654'
Drlg 3010'
- 6/29 Drlg 4010
- 7/8 Lansing 3691'
BKC 4030'
Mississippi 4077'
Viola 4145'
Simpson 4186'
Arb. 4297'
TD 4307'
5" @ 4300'
- 7/14 "
- 7/21 "
- 7/28 "
- 8/4 PB 3610'
- 8/11 "
- 8/18 Lansing 3691'
Arbuckle 4297'
5" @ 4300'
TD 4307'
Perf ans.
500 acid
Pump 272 Oil / 32 W Pot
409 Gr.
Comp

COMPLETED

Map No. _____ Sec. 32 Twp. 26 R. 12W

Well No. 4 Miskiman

Tidewater Company

FIRST REPORT

Contractor _____

NW SE SW

SECTION PLAT

_____ Ft. from N. Line

990

_____ Ft. from S. Line

990

_____ Ft. from E. Line

_____ Ft. from W. Line

	o		

Pratt County

Location _____

Rig up _____

Drilling and Remarks:

drlg. 540

RECORD

Cased _____ in., _____ ft.

Sand _____

Gas _____

Oil _____

Total Depth _____

PRODUCTION

1st 24 hrs. Nat. _____

1st 24 hrs. after shot _____

Gas _____ Cu. Ft.

Dry Hole _____

Abandoned _____

Date

JUN 16 1948

19

S. J. LEWIS

Scout

