

KANSAS

, Pratt


FORM 51 5M PETROL

Section 32 Township 26 Range 12W

Well No. #4 Miskiman

Company Skelly

Gadmi Pool NORTH

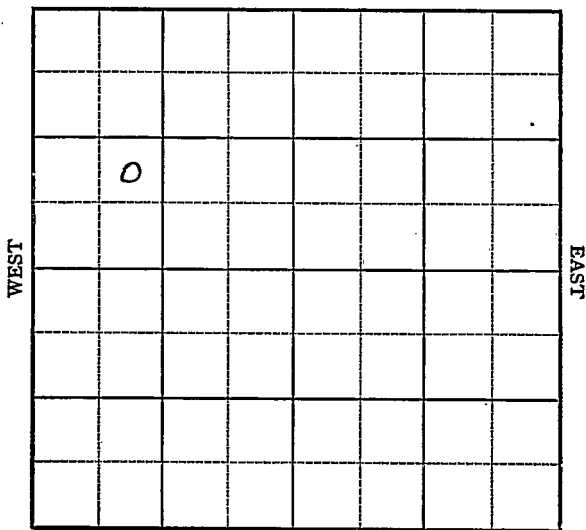

SOUTH

Sec. 32 Twp. 26 R. 12-W

Well No. #4 Miskiman Farm

Skelly Company

NE SW NW


_____ Ft. from N. Line

990 Ft. from S. Line

_____ Ft. from E. Line

990 Ft. from W. Line

Elev. 1909

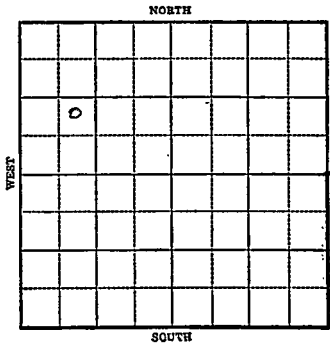

1943

R E P O R T

12-29

Location

1944

1-5

Derrick

1/12

Rotary

1/19

8" @ 424

WOE.

1/26

Drlg. 2000'

2-2-

Drlg. 3250'

* 2-9

Lans 3693'

Viola 4125'

Simp 4174'

Arb 4279'

TD 4286'

5" at 4280'

RUST

2-16

"

2/23

"

3/1

"

3/8

5" @ 4280

Arb 4279'

TD 4310

1750 acid

Bonb Pot 8529

Max 3000

Gravity 40.9

COMPLETED

KANSAS
 Map No. 47 Sec. 32 Twp. 26 R. 12W

Well No. 4 Miskimen

Skelly Company

FIRST REPORT Contractor

NE SW NW

SECTION PLAT

_____ Ft. from N. Line

990 Ft. from S. Line

_____ Ft. from E. Line

990 Ft. from W. Line

Garmi Pool

Location X

Rig up _____

Drilling and Remarks:

RECORD

Cased _____ in., _____ ft.

Sand _____

Gas _____

Oil _____

Total Depth _____

PRODUCTION

1st 24 hrs. Nat. _____

1st 24 hrs. after shot _____

Gas _____ Cu. Ft.

Dry Hole _____

Abandoned _____

Date

DEC 29 1943 19 _____

S. J. LEWIS Scout

KANSAS 47
 Map No. 47 Sec. 32 Twp. 26 R. 12W

Well No. 4 Miskiman

Skelly Company

COMPLETED Contractor

NE SW NW

SECTION PLAT

_____ Ft. from N. Line

990 Ft. from S. Line

_____ Ft. from E. Line

990 Ft. from W. Line

o			

Carmi Pool

Location _____

Rig up _____

Drilling and Remarks:

Per 4279
5" @ 4280
1750 acc'd
Bomb & Prod 8329
Max 3000
48 1/2 in

RECORD

Cased _____ in., _____ ft.

Sand _____

Gas _____

Oil _____

Total Depth 4310

PRODUCTION

1st 24 hrs. Nat. _____

1st 24 hrs. after shot _____

Gas _____ Cu. Ft.

Dry Hole _____

Abandoned _____

Date

MAR 8 1944 19

S. J. LEWIS Scout