FORM 51 25M 3-49 PETROL


KANSAS

Pratt

Section 32 Township 26S Range 12W

Well No. #6 Miskiman

Company Skelly

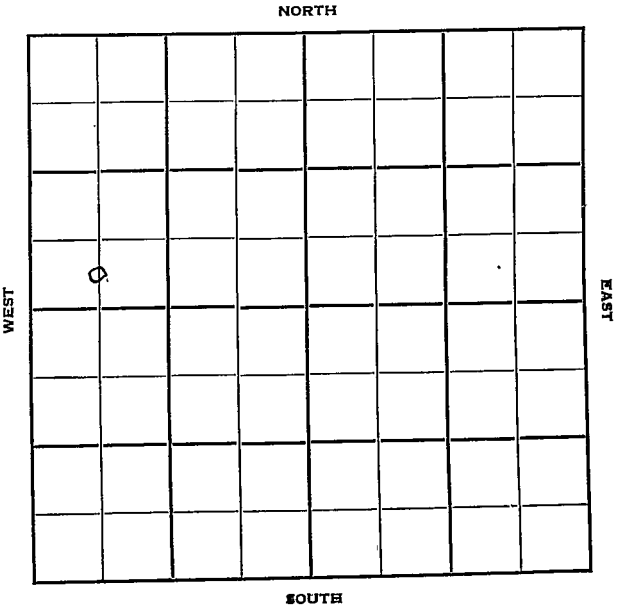

FORM 252-A
5M 10-48 PETROL

KANSAS Pratt

Sec. 32 Twp. 26 R. 12-W

Well No. #6 Miskiman Farm

Skelly Company

Carmi Pool


____ Ft. from N. Line

330 Ft. from S. Line

____ Ft. from E. Line

660 Ft. from W. Line

C S L SW NW

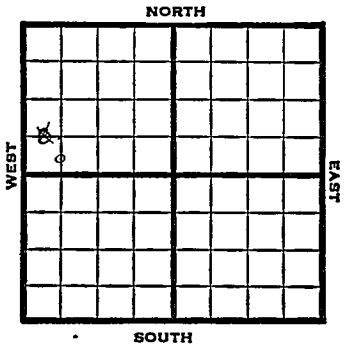

1949	Elev. 1907 REPORT
10/5	8"@ 448'
10/12	Drlg 3200'
10/19	Drlg 3975'
10/26	Lansing 3695'
	Miss 4058'
	Viola 4089'
	Simp-sd 4198'
	Arbuckle 4288'
	TD 4291'
	5" @ 4290'
11/1	221 shots 4183-4221
	Flow 120 bbls oil 8 hrs.
11/9	TD 4291'
	Simp 4172'
	Arb. 4228'
	5"@ 4290'
	Perf Simp
	Echo Pot 3000 Oil
	41° Gr.
	Comp

COMPLETED

Form 26 200 Bks. 6-49 Petrol

Kansas

Cammi Pool

Map No. ____ Sec. 32 Twp. 26 R. 12W


Well No. 6 Miskiman

Skelly Company

Contractor

C S L S W NW

FIRST REPORT
SECTION PLAT

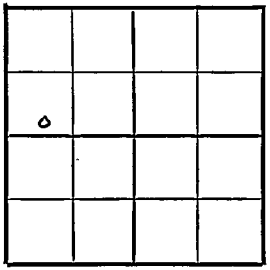

____ Ft. from N. Line

330 Ft. from S. Line

____ Ft. from E. Line

660 Ft. from W. Line

Pratt County

Location

Rig up

Drilling and Remarks:

8" @ 448

RECORD

Cased ____ in., ____ ft.

Sand

Gas

Oil

Total Depth

PRODUCTION

1st 24 hrs. Nat.

1st 24 hrs. after shot

Gas ____ Cu. Ft.

Dry Hole

Abandoned

Date

OCT 5 1949 19

S. J. LEWIS Scout

Form 26 200 Bks. 6-49 Petrol

Kansas

Carmi Pool

Map No. ____ Sec. 32 Twp. 26 R. 12W

Well No. 6 Miskiman

Skelly Company

COMPLETE Contractor

C S L SW NW

Ft. from N. Line


330 Ft. from S. Line

Ft. from E. Line

660 Ft. from W. Line

Elev. 1902

SECTION PLAT

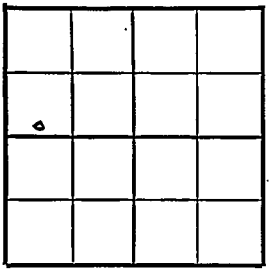

Pratt County

Location

Rig up

Drilling and Remarks:

Sim 4172
Ce 4225
5" @ 4296
Perf Simp
Echo Pt 3000 ac
41° Gr

RECORD

Cased ____ in., ____ ft.

Sand

Gas

Oil

Total Depth 4291

PRODUCTION

1st 24 hrs. Nat.

1st 24 hrs. after shot

Gas ____ Cu. Ft.

Dry Hole

Abandoned

Date

NOV 9 1949

19

S. J. LEWIS Scout