
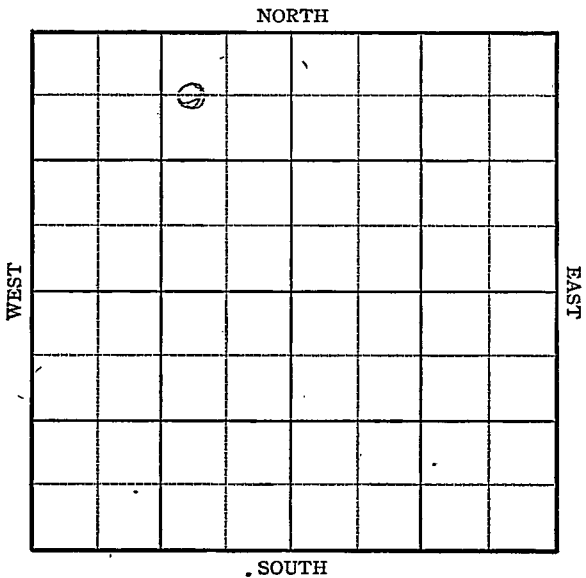


Company Skelly

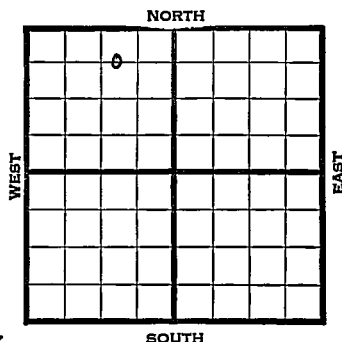

KANSAS Pratt

Sec. 33 Twp. 26 R. 12-WWell No. #3 Lutes FarmSkelly Company660 Ft. from N. Line Ft. from S. Line990 Ft. from E. Line Ft. from W. Line

C W L NE NW Elev. 1906

1945

REPORT

7/18 RUR
7/26 8" @ 386
Drig. 1925
8/1 Drig. 3635
8/8 Lans 3685
Viola 4116
Simp Sh 4183
Arb. 4277-4286
TD 4286 Sat.
~~8/25~~ Run 5"
8/15 5" @ 4278
TD 4299
800' oil 6 hrs.
8/22 Arb. 4277
5" @ 4278
500 acid
TD 4299
Pump 350 Pot.
Grav. 40.9

COMPLETED

KANSASPool Name Carmi

Kansas

Map No. 47 Sec. 33 Twp. 26 R. 12WWell No. 3 LutesSkelly

Company

FIRST REPORT

Contractor

C W L NE NW**SECTION PLAT**

	o		

660 Ft. from N: Line Ft. from S. Line990 Ft. from E. Line Ft. from W. LinePratt CountyLocation Rig up

Drilling and Remarks:

RUR**RECORD**Cased in. ft.Sand Gas Oil Total Depth **PRODUCTION**1st 24 hrs. Nat. 1st 24 hrs. after shot Gas Cu. Ft.Dry Hole Abandoned

Date

JUL 1 8 1945 19S. J. LEWIS

Scout

KANSAS Kansas Pool Name CarmiMap No. 47 Sec. 33 Twp. 26 R. 12WWell No. 3 LutesSkelly Company**COMPLETED**

Contractor

C W L NE NW

E 11906
SECTION PLAT660 Ft. from N. Line Ft. from S. Line990 Ft. from E. Line Ft. from W. Line

	6		

Pratt CountyLocation Rig up

Drilling and Remarks:

Art 42775" @ 4278500 @ 4278Prod 300 B.D.400 @ 4278**RECORD**Cased in., ft.Sand Gas Oil Total Depth 4298**PRODUCTION**1st 24 hrs. Nat. 1st 24 hrs. after shot Gas Cu. Ft.Dry Hole Abandoned

Date

AUG 22 194519S. J. LEWISScout