


Pratt

KANSAS

Section 20 Township 26 Range 12W

Well No. #2 Hoemr (Hoeme)

Company Transit Corp.

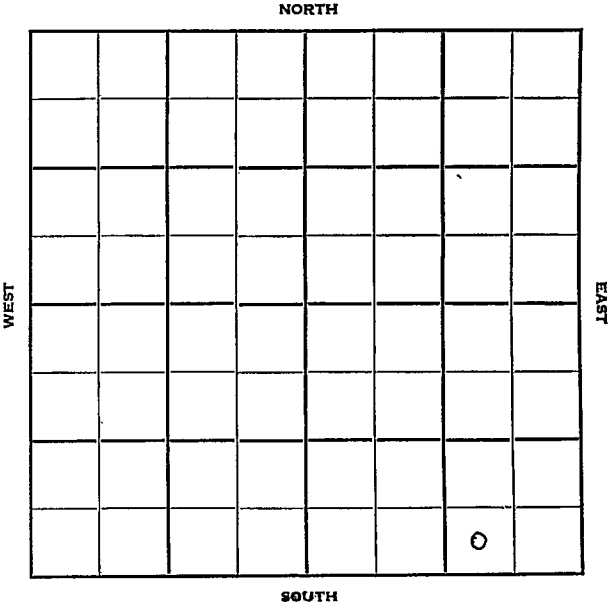

Pratt

KANSAS

Sec. 20 Twp. 26 R. 12 W

Well No. # 2 Hoeme Farm

Transit Corp. Company

Contractor

Inka


Ft. from N. Line

330 Ft. from S. Line

990 Ft. from E. Line

Ft. from W. Line

SW SE SE

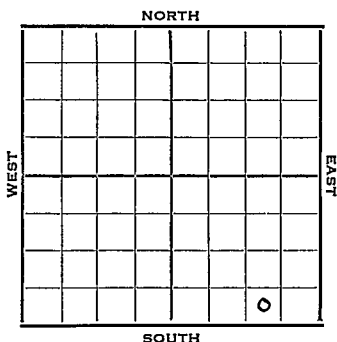

1951 Elev. 1916' REPORT

11/28 Spud 11-24-51
8" @ 437' WOC

1952
2/6 Spud 11-24-51
Oil Well TD 4319
8" @ 437' Heeb. 3489
Br lime 3663 KC 3688
DST 3785-97 opn 2 hr.
Rec. 90' sw w/SSO
DST 3845-75 opn 1 hr Rec. 60' hoem
255' oil
DST 3908-26 opn 1 hr. Rec. 340' oil
Miss 4049 Viola 4069
DST 4067-4140 opn 2 hr.
Rec. 155' hgcm
DST 4110-65 opn 2 hr.
Rec. 300' gas 35' gcm
DST 4168-90 opn 2 hr.
Rec. 35' sgcm 420' gas
Simp sd 4210 Arb. 4311
TD 4314 5" @ 4313 DD 4319
B/5 boph 500 A S/17 boph 9 hr.
Comp. 152 bopd 15% wtr.

COMPLETED

Print

State Kansas

(Blk.)
(Twp.)

(Sur.)
(Rge.)

12W

Map No.

Transit Corp.

2

Farm

Feem2

1916

Location

SW SE SE

FIRST REPORT

330

Ft. From

S Line

SE

990

Ft. From

E Line

Quarter

100

NOV 28 1951

Completion

Remarks

Spudding Date


11-24-51

Drlg. Data

Take

8th @ 437 W. OC.

J. E. TYRA

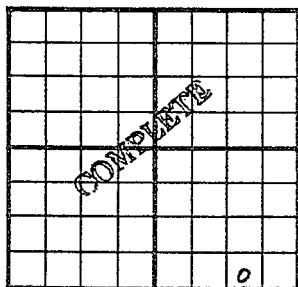County Pratt State KansasSec. 20 (Blk.) 26 (Sur.) 12W Map No.Operator Transit Corp.Well No. 2 Farm HoemeElev. 1916 Location SW SE SE330 Ft. From S Line SE990 Ft. From E Line Quarter

1st. Report

Completion FEB 6 1952Remarks Iuka PoolSpudding Date 11-24-51Drig. Data Oil well TD 43198" @ 437 Heeb. 3489 Br. lime 3663KC 3688 DST 3785-97 open 2 hr.Rec. 90' sw w/ SSO DST 3845-75 open 1 hr.Rec. 60' hocom 255' oil DST 3908-26open 1 hr. Rec. 340' oil Miss. 4049Viola 4069 DST 4067-4140 open 2 hr.Rec. 155' hgcm DST 4110-65 open 2 hr.Rec. 300' gas 35' gcm DST 4168-90open 2 hr. Rec. 35' sgcm 420' gasSimp. sd. 4210 Arb. 4311 TD 43145" @ 4313 DD 4319 B/ 5 goph 500 AS/ 17 boph 9 hr.Comp. 152 bopd 15% water

J. G. McGEHEE