


O. W. D. D

Section 20 Township 26 Range 12W

Well No. #3 Hoeme

Company Transit Corp.

NORTH

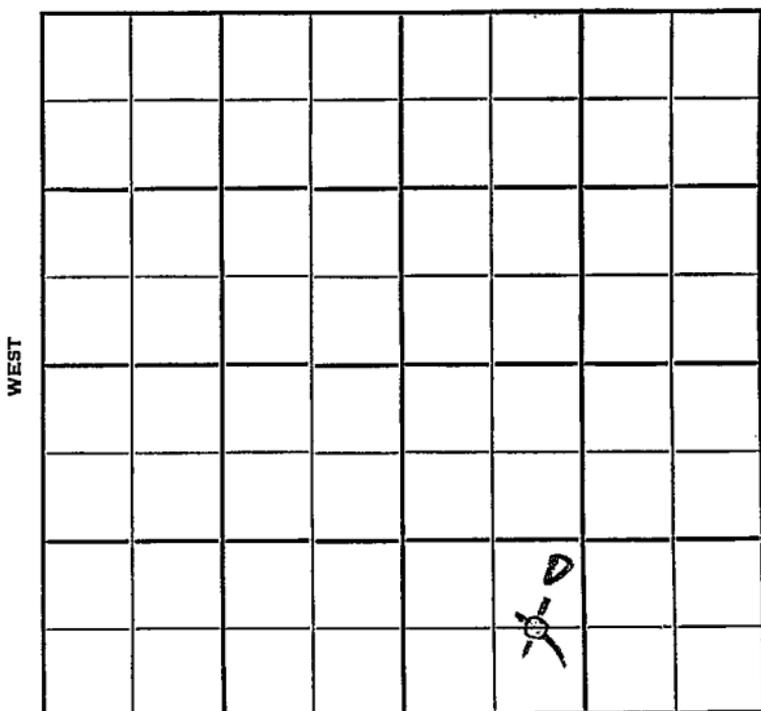

SOUTH

O. W. D. D Pratt KANSAS

Sec. 20 Twp. 26 R. 12 W

Well No. # 3 Hoeme Farm

Transit Corp. Company

Carmi-Tuka Contractor

Ft. from N. Line

990
~~660~~


Ft. from S. Line

Ft. from E. Line

990

Ft. from W. Line

~~C E/2 SW SE~~
NE SW SE

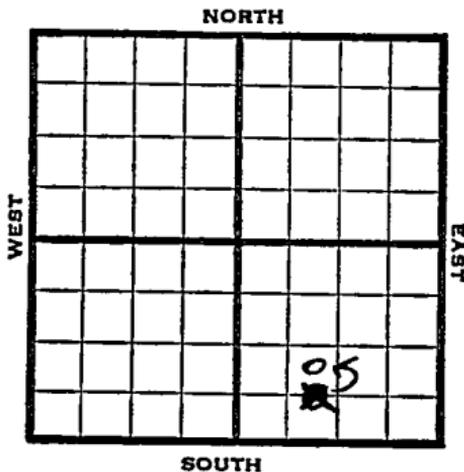

1952 Elev. 1909' REPORT

1/16 RUR

2/6 Miss 4046 V 4074
Simp 4185

Cored 4217-67 Arb. 4310-30 RFD
5" @ 4330 WQC

2/13 DP CO to 4295'

2/20 64/4231-47 Hydra S/1 1/4 boph for 24
hrs PB 4229
36/4220-29 Hydr.

3/5 NR

3/12 Sq off 3914-26 DC 4256
6 BO & 2 BWPH POP

3/19 POP

3/25 NR

4/1 500,000 gas

4/9 NR

4/23 "

4/30 "

5/7 "

5/14 "

OVER

1952
5/21

Spud 1-16-52
D & A TD 4330' 8" @ 446
Anhy 806' -- Heeb 3488' Tor. 3500'
Br. lime 3660' Lans. 3685'
DST 3794-3843 open 2 hr, rec 210' SW
SSO, 150' gas.
DST 3850-75 open 1 hr. 40 min, rec 1500
gas, 55' GCM
DST 3911-33 open 2 hr, rec 55' OCM
65' WCM--
Miss 4046' Viola 4074 Simp 4185'
Arb. 4310'-30' 5" @ 4330' CO to 4295'
64/4231-47 Hydro. 1 1/2 BOPH PB 4229'
36/4220-29 Hydro. 2 BO 1 BW PB 4110
72/4076-94 2000 A 1/2 MCFG 20 GWPB
PB 3940' 38/3914-26 DC to 4256'
6 BO 2 BWPH 500,000 gas.
D & A

ABANDONED

1952
8/20

O. W. D. D

Heeb. 3488 Br Li 3659
Lans. 3685 Miss 4046
V. 4074 Simp. 4185
Arb. 4310
OTD 4330 5" @ 4330 D&A
DD 4336' 2 1/2 Boph for 8 hrs. 250 A
S/ 13 Boph 1000' off Btm. POP

8/27

NR

9/3

"

9/10

"

9/17

"

9/24

"

10/1

Oil Well TD 4336 ^W D. D
Heeb. 3488 Br Li 3659
Lans. 3685 Miss. 4046
Viola 4074 Simp. 4185
Arb. 4310 OTD 4330
5" @ 4330' DD 4336 2 1/2 boph
250 A S/ 13 boph
Comp. 420 bopd 10% wtr.

COMPLETED


County **Pratt** State **Kansas**

Sec. **20** (Blk. Twp.) **26** (Sur. Rge.) **12W** Map No.

Operator **Transit Corp.**

Well No. **3** Farm **Hoeme**

Elev. Location **C E/2 SW SE**

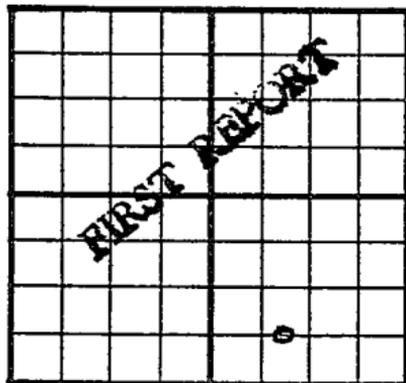

660 Ft. From **S** Line **SE**

990 Ft. From **W** Line Quarter

Ist. Report **JAN 16 1952**

Completion

Remarks

Spudding Date

Drlg. Data **Carmi-Tuka**

RUR

J. E. TYRA