


KANSAS Pratt County

Section 21 Township 26 Range 12W

Well No. #1 Knop

Company Bishop Oil

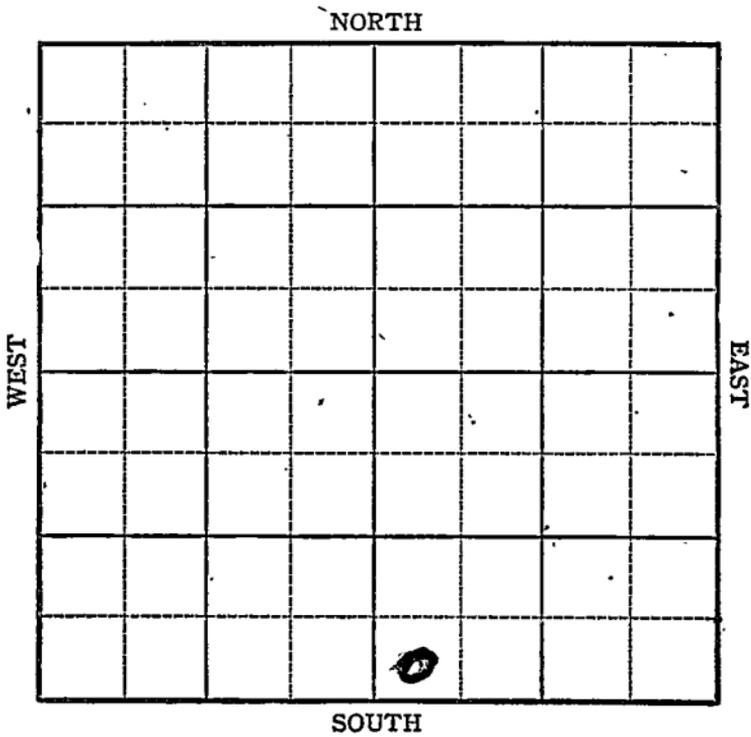

Sec. 21 Twp. 26S R. 12W

Well No. #1, Knop Farm

Bishop Oil Company


**Carmi**

\_\_\_\_\_ Ft. from N. Line

330 Ft. from S. Line

\_\_\_\_\_ Ft. from E. Line

330 Ft. from W. Line

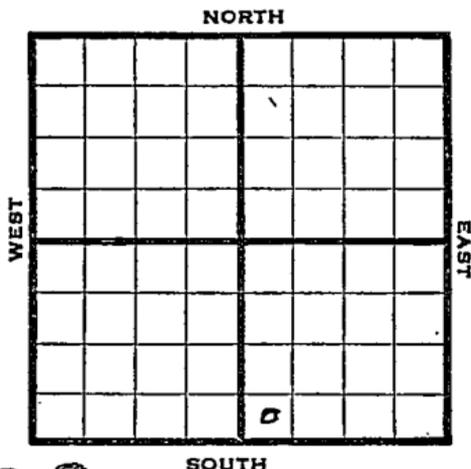

SW SE *Edw. 1922*

1945

R E P O R T

- 1-3 Location
- 1/10 Derrick
- 1/17 10" @ 449  
Drlg 1810
- 1/26 Lans 3698  
Drlg. 3840'
- 1/31 Arb. 4351  
TD 4386'
- 2/7 Viola 4143  
Simp Sh 4228  
Sand 4293. - 4305 SO
- 2/14 Arb. 4351  
5" @ 4338  
TD 4426

**ABANDONED**

Pool Name Carmi

Map No. K-47 Sec. 21 Twp. 26 R. 12W

Well No. 1 Knop

Bishop Oil Company

ABANDONED

Contractor

SW SE

SECTION PLAT

         Ft. from N. Line

330 Ft. from S. Line

         Ft. from E. Line

330 Ft. from W. Line


Pratt County

Location                                 

Rig up                                 

Drilling and Remarks:

*Cor 4351  
5" @ 4338*

RECORD

Cased          in.,          ft.

Sand                                 

Gas                                 

Oil                                 

Total Depth 4426

PRODUCTION

1st 24 hrs. Nat.                                 

1st 24 hrs. after shot                                 

Gas                                  Cu. Ft.

Dry Hole                                 

Abandoned                                 

Date


FEB 14 1945 19         

S. J. LEWIS Scout

Pool Name CarmiMap No. 47 Sec. 21 Twp. 26 R. 12WWell No. 1 KnopBishop Oil CompanyFIRST REPORT Contractor

SW SE

SECTION PLAT

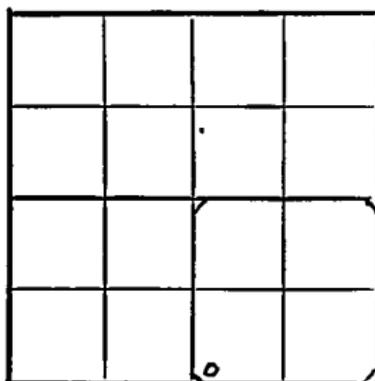           Ft. from N. Line330 Ft. from S. Line           Ft. from E. Line330 Ft. from W. LinePrettLocation XRig up           

Drilling and Remarks:

## RECORD

Cased            in.,            ft.Sand           Gas           Oil           Total Depth           

## PRODUCTION

1st 24 hrs. Nat.           1st 24 hrs. after shot           Gas            Cu. Ft.Dry Hole           Abandoned           

Date

JAN 3 , 1945 19S. J. LEWIS Scout