

PRATT

KANSAS

DX 78-1

22

26S

12W

Section _____ Township _____ Range _____

#1 Haas

Well No. _____


Shelley-Miller Drlg.

Company _____

NORTH

WEST

EAST

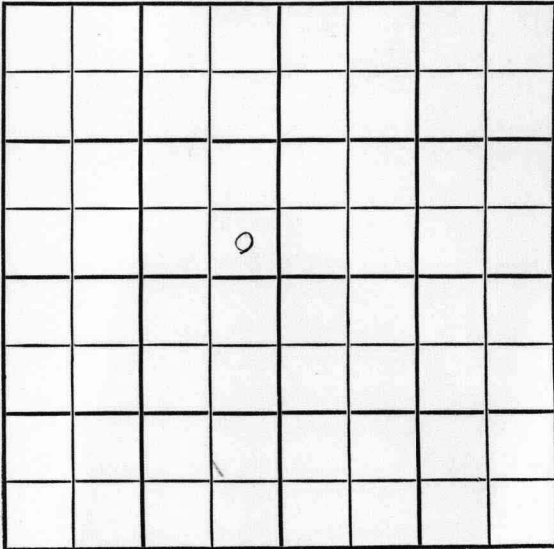

SOUTH

Pratt

SEC.

TWP.

R.

22

26S

12W

WELL NO.

1 Haas

FARM

COMPANY

Shelley-Miller Drlg.

CONTRACTOR

Glen Thrasher Co.

Semi-WILDCAT


_____ FT. FROM N. LINE

_____ FT. FROM S. LINE

_____ FT. FROM E. LINE

_____ FT. FROM W. LINE

SE SE NW

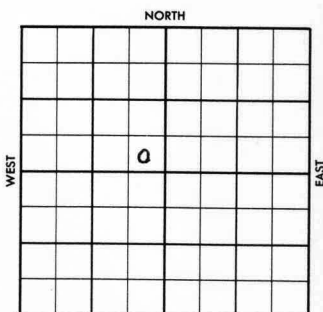

Amerada DHM

ELEVATION

1956

1906 DF

REPORT

6-20

Comm. 6-13-56
 8" @ 661 w/325
 Drlg. 3245
 Anh. 1150

7-3

DST 3928-60 op 1 hr. rec. 30' WM(spks. oil), BHP 55/30".
 DST 4102-56 op 1 hr. rec. 110' mud, BHP 110.
 D & A
 H. 3497', Dg. 3529', BL. 3672', L. 3699'
 C. 4102', M. 4153', K. 4228', V. 4248', S. 4313', A. 4400'.
 Log tops:
 BL. 3622', L. 3698', C. 4101',
 M. 4156', K. 4229', V. 4248', S. 4313',
 A. 4402'
 TD 4420'.

ABANDONED

County	Pratt		Elev.	1906 DE	
Sec.	22	Twp.	26S	Rge.	12W
Company	Shelley-Miller Drlg.				
Owner	Haas				
No.	1				

SPS	DEPTH	LOG	DATUM	Loc. in Sec.
	1120			SE SE NW
TP.	3497			Amer. DHM
H.	3529			
Tr.	3672	3622		
Dg.	3699	3698		Geol. Glen Thrasher
BL.				Contr.
L.				Co.
K.C.				
B.K.C.				
Ce.	4102	4101		
C.				
M.				
M.	4153	4156		Pool
K.	4228	4229		Semi-WC
Mz.				
Me.				
V.	4248	4248		
S.	4313	4313		
S.				
A.	4400	4402		
R.				
PE.				
G.				
TD.	4420			

Date Comm. 6-13-56 JUL 3 1956
 8" 661 w/325; D 3245 JUN 27 '56 H6 3497

Dg 3529 BL 3672 L59 3699 DST
 3928-60 op 1 hr run 30' WM (spks
 oil) BHP 55/30" C9 4102 DST
 4102-56 1 hr run 110' Md BHP
 110/ Miss 4153 ID 4231 JUL 3 '56 X
 Rd 4228 V10 4248 SP 4313 ARX
 4400 RTD 4420 DE' Q
 Log Tops Rig to Barton

County Pratt Elev. 1906 DE
 Sec. 22 Twp. 26S Rge. 12W
 Company Shelley-Miller Drilg.
 Farm Name Haas No. 1

TOPS	DEPTH	LOG	DATUM	Loc. in Sec.
Anh.	1150			SE SE NW
TP.				Amer. DHM
H.				Glen Thrasher
Tr.				Contr.
Dg.				Co.
Bl.				Pool
L.				Semi-WC
K.C.				FIRST REPORT
B.K.C.				
Ce.				
C.				
M.				
M.				
K.				
Mz.				
Me.				
V.				
S.				
S.				
A.				
R.				
PE.				
G.				
T.D.				

Date Comm. 6-13-56

JUN 20 '56

8" 661 w/325; D 3245

0001 2 S NUL