
FORM 51 25M 8-50 WESTERN

Pratt KANSAS

Section 24 Township 26 Range 12 W

Well No. #1 Gatz

Company W. L. Hartman

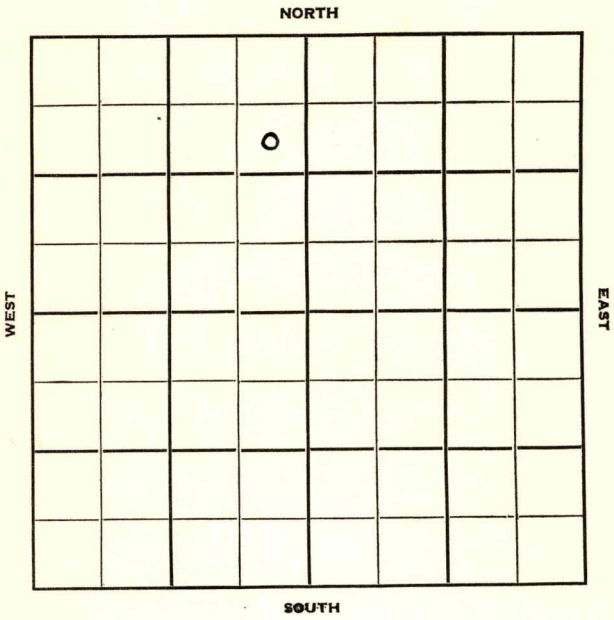

FORM 252-B
10M 10-50 PETROL

Pratt KANSAS ✓

Sec. 24 Twp. 26 R. 12W

Well No. #1 Gatz Farm

W. L. Hartman Company

Contractor

Wildcat


990' Ft. from N. Line

Ft. from S. Line

330' Ft. from E. Line

Ft. from W. Line

SE NE NW

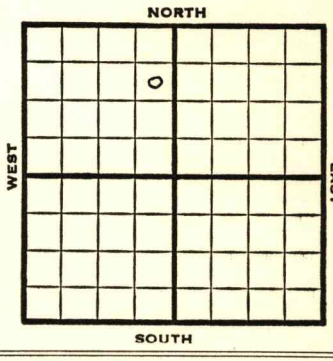

1951	Elev. 1863' REPORT
1/17	Drlg.
2/14	Spud 1-19-51 D&A TD 4318' 8-5/8" @ 365' Heeb. 3408' Lans. 3604' DST 3672-85 opn 45 min Rec. 25'mud DST 3697-3716 opn 1 hr Rec. 40' gcm 120' gas DST 3756-69 opn 1 hr Rec. 840' gas 35' mud DST 3868-85 opn 1 hr Rec. 25' mud 120' gas Viola 4126' DST 4129-40 opn 45 min Rec. 60' gas 30' gcm DST 4140-50 opn 1 hr Rec. 59' mud SSO DST 4150-58 opn 1 hr Rec. 900' gas 61' mud & wtr Simp. 4200' Arb. 4300' TD 4318' D&A ABANDONED

FORM 275 FOR SALE BY KANSAS BLUE PRINT CO.


County Pratt State Kansas

Sec. 24 (Blk. Twp.) 26 (Sur. Rge.) 12W Map No.

Operator W. L. Hartman

Well No. 1 Farm Gatz

Elev. Location SE NE NW

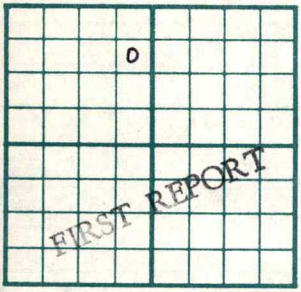

990 Ft. From N Line NW

330 Ft. From E Line Quarter

1st. Report JAN 17 1951

Completion

Remarks

Spudding Date

Drlg. Data Wildcat

drlg.

J. E. TYRA

FORM 275 FOR SALE BY KANSAS BLUE PRINT CO.

County Pratt State Kansas

Sec. 24 (Blk. Twp.) 26 (Sur. Rge.) 12W Map No.

Operator W. L. Hartman

Well No. 1 Farm Gatz

Elev. 1863 Location SE NE NW



990 Ft. From N Line NW

330 Ft. From E Line Quarter

1st. Report

Completion FEB 14 1951

Remarks Wildcat
Hartman - Contr.

Spudding Date 1-19-51

Drlg. Data D & A TD 4318

8 5/8" @ 365 Heeb. 3408 Lans. 3604

DST 3672-85 open 45 min. Rec. 25' mud

DST 3697-3716 open 1 hr. Rec. 40' gcm

120' gas DST 3756-69 open 1 hr.

Rec. 840' gas 35' mud DST 3868-85

open 1 hr. Rec. 25' mud 120' gas

Viola 4126 DST 4129-40 open 45 min.

Rec. 60' gas 30' gcm DST 4140-50

open 1 hr. Rec. 59' mud SSO DST 4150-58

open 1 hr. Rec. 900' gas 61' mud & water

Simp. 4200 Arb. 4300 TD 4318

D & A

J. E. TYRA