

KANSAS

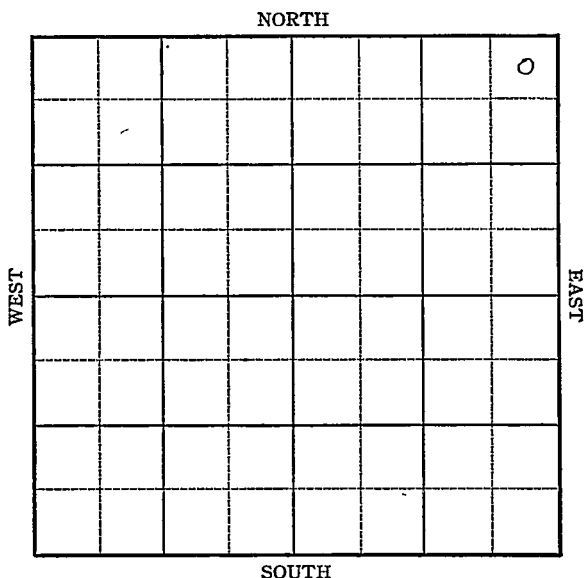
Pratt

FORM 51 5M 1-42 PETROL

Section 24 Township 26 Range 12-W

Well No. #1 Hoover Estate

Company Superior Oil of Calif.

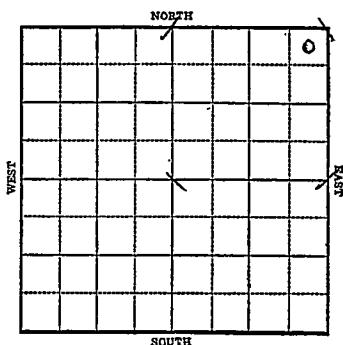


KANSAS

Pratt

Sec. 24 Twp. 26 R. 12-WWell No. #1 Hoover Estate Farm
Superior Oil of Calif Company

Wildcat

330 Ft. from N. Line Ft. from S. Line330 Ft. from E. Line Ft. from W. Line*Elw. 1870 (st)*

1943

R E P O R T

3/24	Location.
3/31	10" @ 317 WOC
4/7	Drlg. 2387'
4/14	Topeka 3154 Douglas 3410 Drlg. 3467'
4/21	Lans 3622 Drlg. 4101
4/28	Kind 4101 Viola 4272 T.D. 4324 SD Repairs.
5/5	" " " "
5/12	" " " "
5/19	Simp. Sd 4361 Arb. 4433 T.D. 4476

ABANDONED

Pratt

KANSAS

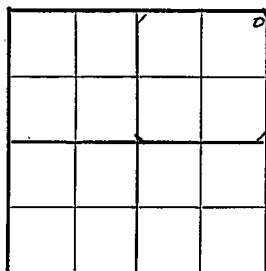
Map No. 47 Sec. 24 Twp. 26 R. 12WWell No. 1 Hoover EstateSuperior Oil of Calif., Company

FIRST REPORT

Contractor

NE/C

SECTION PLAT

330 Ft. from N. Line Ft. from S. Line330 Ft. from E. Line Ft. from W. Line

WILDCAT

Location XXXRig up

Drilling and Remarks:

RECORD

Cased in., ft.Sand Gas Oil Total Depth

PRODUCTION

1st 24 hrs. Nat. 1st 24 hrs. after shot Gas Cu. Ft.Dry Hole Abandoned

Date

MAR 24 1943

19

S. J. LEWIS

Scout

KANSAS

Pratt

Map No. 47 Sec. 24 Twp. 26 R. 12WWell No. 1 Hoover EstateSuperior Oil of Calif. Company
ABANDONED

Contractor

NE/C

SECTION PLAT

330 Ft. from N. Line Ft. from S. Line330 Ft. from E. Line Ft. from W. Line

			6

WILDCAT

Location

Rig up

Drilling and Remarks:

Simple Sol 4361
Cor 4433

RECORD

Cased in., ft.Sand Gas Oil Total Depth 4476

PRODUCTION

1st 24 hrs. Nat. 1st 24 hrs. after shot Gas Cu. Ft.Dry Hole Abandoned

Date

MAY 19 1943

19

S. J. LEWIS

Scout